

REC'D JUL 5 1996

GRANT COUNTY

Survey Monument Record

TYPE OF MONUMENT 3/4" X 24" IRON BAR
STATE PLANE COORDINATES: N SET W/ CAP
E _____

ELEVATION — M.S.L. DATUM: _____

THETA ANGLE: _____

FIELD BOOK: 95-18


PAGE 25

CORNER NO. _____

SECTION 21

TOWN 6N

RANGE 1W

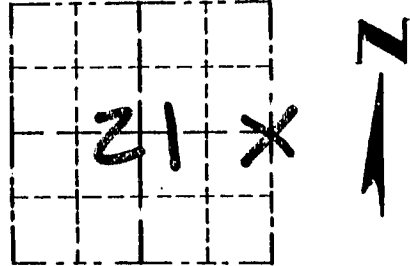


LOCATION
(Indicated by "X")

BASIS FOR MONUMENT LOCATION

(Use reverse side if necessary)

ORIGINAL CORNER SET IN
1833 B4 SIBLEY. NO RECORD
FOUND SINCE ORIGINAL
SURVEY. I ACCEPTED AN
OCCUPATION LOCATION &
VERIFIED 1/2 MILE NORTH AN
SOUTH B4 EDM TRAVERSE
OF THE AREA.

SEAL:

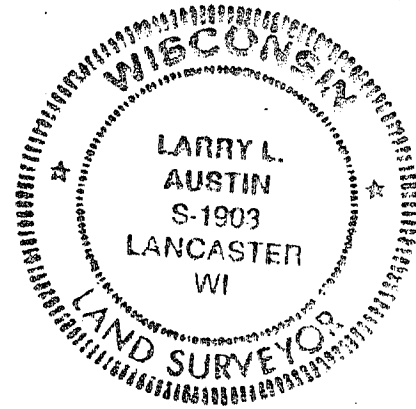

CERTIFIED CORRECT

Larry L. Austin
Registered Land Surveyor

DATE: 5-9-96

TIE SKETCH

Show at least three (3) ties and monument


LEGEND

FIELDS

⊕ 3/4" X 24" IRON BAR
SET W/ CAP

○ 1/2" X 15" IRON BAR SET

-- EXISTING FENCE

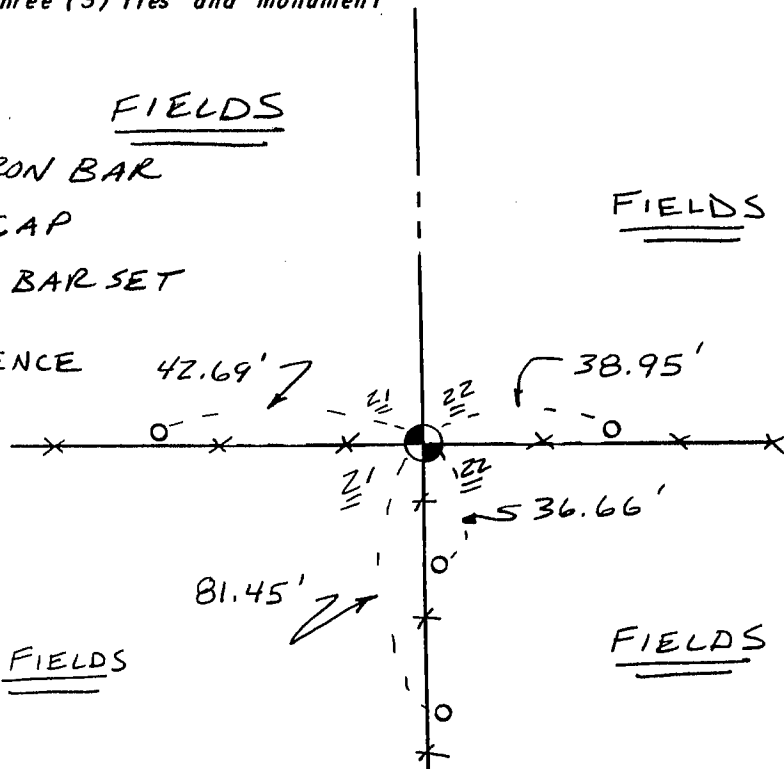

No SCALE