

Survey Monument Record


TYPE OF MONUMENT 1/4" IRON PIPE  
 STATE PLANE COORDINATES: N \_\_\_\_\_  
 E \_\_\_\_\_  
 ELEVATION — M.S.L. DATUM: \_\_\_\_\_  
 THETA ANGLE: \_\_\_\_\_  
 FIELD BOOK: \_\_\_\_\_  
 PAGE \_\_\_\_\_

CORNER NO. \_\_\_\_\_  
 SECTION 22  
 TOWN 6N  
 RANGE 1W

BASIS FOR MONUMENT LOCATION

(Use reverse side if necessary)

Show info such as: History of corner, with reference to Vol. and pg., dates, surveyor; exact description of monument replaced; if location computed, by taped or EDM traverse; landowner, remarks, etc.

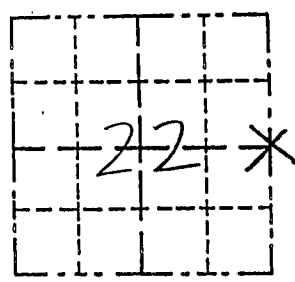

LOCATION  
(Indicated by "X")

- FOUND PERPETUATED LOCATION
- OBLITERATED EVIDENCE LOCATION
- LOST CORNER (RESTORED BY PROPORTIONATE METHODS)

There are no recent <sup>OR OLD</sup> survey records of this corner. The occupied location of fences N, S, & E fell approx. 20' east of a straight line between existing monuments at the NE & SE corners. Ownership records as well as verbal statements indicate continuous occupation at this corner since the mid 1800's. Topographical considerations would also explain the deviation from line. The restored corner was placed at double the easting between the c/4 and occupied SW corner of the SE 1/4-NE 1/4 in line with the fence line east. This location provided the best fit of occupied lines to N, S, E and within section 22. (see survey, this date for details)

CERTIFIED CORRECT TO THE BEST OF MY KNOWLEDGE AND BELIEF

Michael R. LaRosa  
Registered Land Surveyor

DATE: 12/30/1997

TIE SKETCH

Show at least (4) ties and monument

