

Survey Monument Record

TYPE OF MONUMENT 3/4" X 24" Iron Rod

STATE PLANE COORDINATES: N _____
E _____

ELEVATION — M.S.L. DATUM: _____

THETA ANGLE: _____

FIELD BOOK: _____

PAGE _____

CORNER NO. _____

SECTION 33


TOWN 6 NORTH

RANGE 1 WEST

BASIS FOR MONUMENT LOCATION

(Use reverse side if necessary)


Show info such as: History of corner, with reference to Vol. and pg., dates, surveyor; exact description of monument replaced; if location computed, by taped or EDM traverse; landowner, remarks, etc.

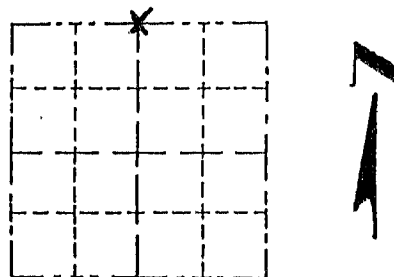

LOCATION
(Indicated by "X")

- FOUND PERPETUATED LOCATION
- OBLITERATED EVIDENCE LOCATION
- LOST CORNER (RESTORED BY PROPORTIONATE METHODS)

I FOUND NO HISTORY OF THIS CORNER SINCE THE ORIGINAL GOVERNMENT SURVEY. I SET THIS CORNER AT A FENCE INTERSECTION THAT I DETERMINED WAS THE BEST REMAINING EVIDENCE AND FIT VERY WELL WITH ALL OTHER OCCUPATION AFTER AN E. D. M. TRAVERSE AND LOCATION SURVEY OF SECTION 32 + 33.

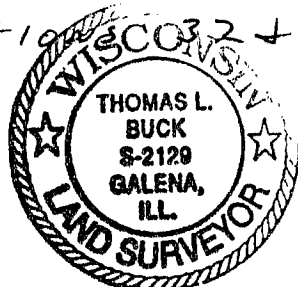


CERTIFIED CORRECT TO THE BEST OF MY KNOWLEDGE AND BELIEF

Thomas Buck
Registered Land Surveyor

DATE: 7/30/99

TIE SKETCH

Show at least three (3) ties and monument

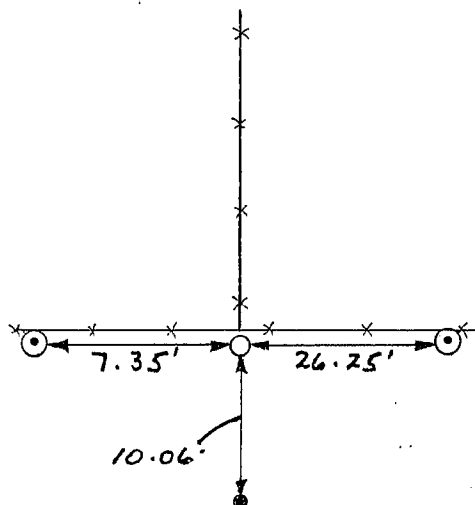

No SCALE

○ = 3/4" X 24" Iron Rod

● = 1/2" Iron Rod

⊙ = P.K. w/SHINER TOP OF POST

--* = EXISTING FENCE