


Survey Monument Record

TYPE OF MONUMENT 3/4" x 24" Iron Rod
 STATE PLANE COORDINATES: N _____
 E _____
 ELEVATION — M.S.L. DATUM: _____
 THETA ANGLE: _____
 FIELD BOOK: _____
 PAGE _____

CORNER NO. _____
 SECTION 32
 TOWN 6 NORTH
 RANGE 1 WEST

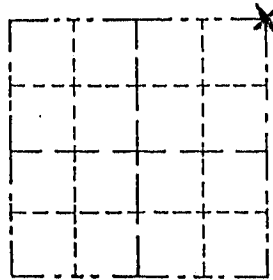

LOCATION
 (Indicated by "X")


- FOUND PERPETUATED LOCATION
- OBLITERATED EVIDENCE LOCATION
- LOST CORNER (RESTORED BY PROPORTIONATE METHODS)

BASIS FOR MONUMENT LOCATION

(Use reverse side if necessary)

Show info such as: History of corner, with reference to Vol. and pg., dates, surveyor; exact description of monument replaced; if location computed, by taped or EDM traverse; landowner, remarks, etc.

I FOUND NO HISTORY OF THIS CORNER SINCE THE ORIGINAL GOVERNMENT SURVEY. I SET THIS CORNER NORTH-SOUTH BY HOLDING THE EAST-WEST FENCE LINE AND EAST-WEST BY USING SINGLE PROPORTIONATE MEASUREMENT ALONG THE NORTH LINE OF SECTION 32 & 33 AFTER AN E.D.M. TRAVERSE. I FOUND THE NORTH-SOUTH FENCE LINE TO BE OF NO USE AT ALL.

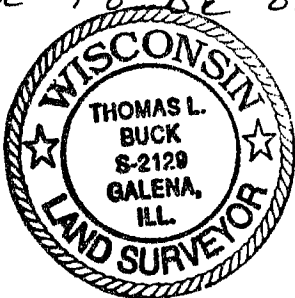


CERTIFIED CORRECT TO THE BEST OF MY KNOWLEDGE AND BELIEF

Thomas Buck
 Registered Land Surveyor

DATE: 7/30/99

TIE SKETCH

Show at least three (3) ties and monument

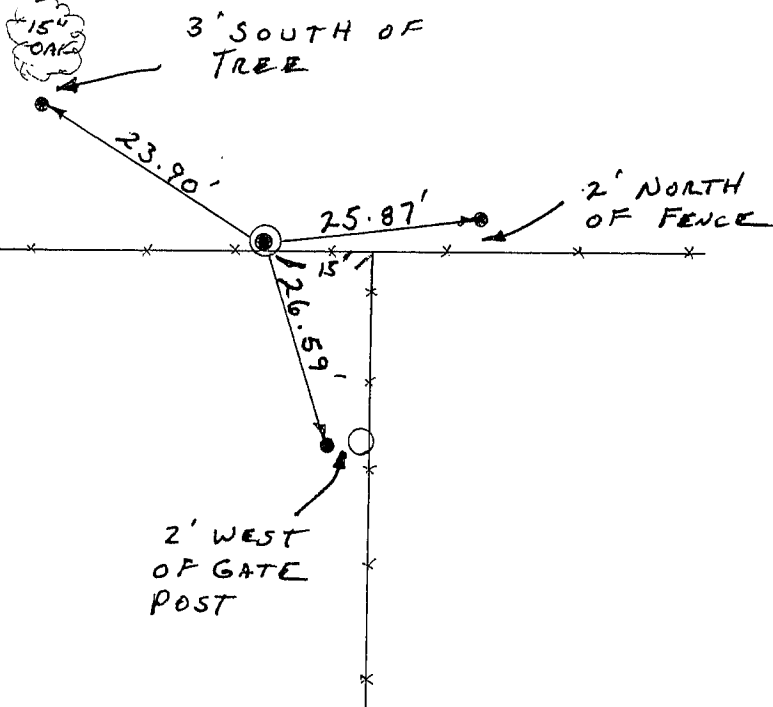

NO SCALE

⊙ = 3/4" IRON ROD

● = 1/2" IRON ROD

* * * = EXISTING FENCE