

Survey Monument Record


TYPE OF MONUMENT 3/4" X 24" IRON ROD
 STATE PLANE COORDINATES: N _____
 E _____
 ELEVATION — M.S.L. DATUM: _____
 THETA ANGLE: _____
 FIELD BOOK: _____
 PAGE _____

CORNER NO. _____
 SECTION 32
 TOWN 6 NORTH
 RANGE 1 WEST

BASIS FOR MONUMENT LOCATION

(Use reverse side if necessary)

Show info such as: History of corner, with reference to Vol. and pg., dates, surveyor; exact description of monument replaced; if location computed, by taped or EDM traverse; landowner, remarks, etc.

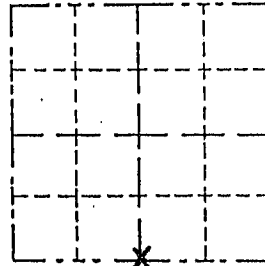


LOCATION

(Indicated by "X")

- FOUND PERPETUATED LOCATION
- DIGITIZED EVIDENCE LOCATION
- LOST CORNER (RESTORED BY PROPORTIONATE METHODS)

I FOUND NO HISTORY SINCE THE ORIGINAL SURVEY. I SET THIS CORNER BY USING THE PROPORTIONATE METHOD AFTER AN E.D.M. TRAVERSE AND LOCATION SURVEY OF SECTIONS 32 & 33.

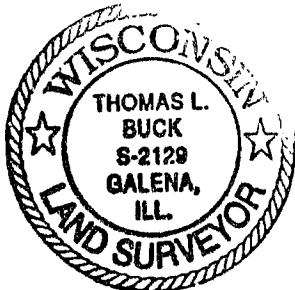

CERTIFIED CORRECT TO THE BEST OF MY KNOWLEDGE AND BELIEF

Thomas Buck
 Registered Land Surveyor


DATE: 7/30/99

TIE SKETCH

Show at least three (3) ties and monument



NO SCALE

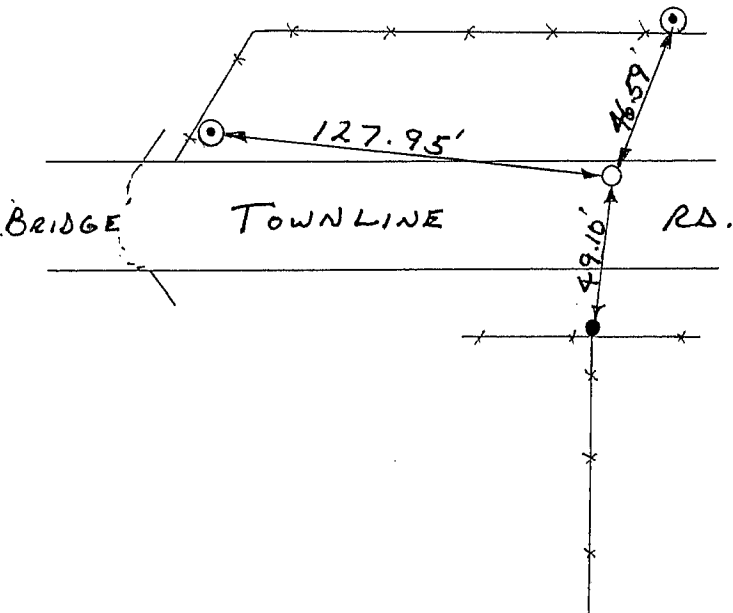

- ⊙ = P.K. W/SHINER TOP OF POST
- = 3/4" X 24" IRON ROD
- = 1/2" IRON ROD
- x—x— = EXISTING FENCE