

Survey Monument Record

TYPE OF MONUMENT 2" X 6" STONE FND.

CORNER NO. 23
 SECTION 01
 TOWN 6N
 RANGE 2W

FIELD BOOK: 96-14
 PAGE (11)




BASIS FOR MONUMENT LOCATION

(Use reverse side if necessary)

Show info such as: History of corner, with reference to Vol. and pg., dates, surveyor; exact description of monument replaced; if location computed, by taped or EDM traverse; landowner, remarks, etc.

SEAL:

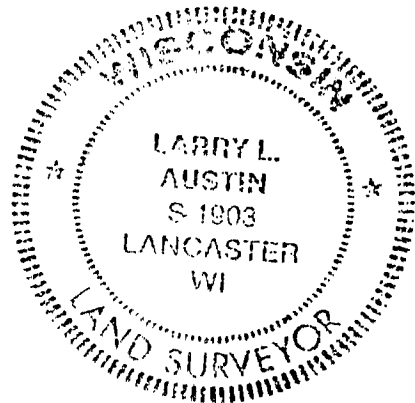

CORNER SET IN 1833 BY HARVEY PARKE. NO RECORD FOUND SINCE ORIGINAL SURVEY; I FOUND A 2" X 6" STONE AT AN OCCUPIED FENCE CORNER. I ACCEPTED ITS LOCATION AFTER A EDM TRAVERSE OF AREA.

CERTIFIED CORRECT

Larry R. Aust
 Registered Land Surveyor

DATE: 3/28/97

TIE SKETCH

Show at least three (3) ties and monument

LEGEND

- ⊕ 2" X 6" STONE FND.
- 1/2" X 15" IRON BAR
- XX EXISTING FENCE

