

GRANT COUNTY

Survey Monument Record

TYPE OF MONUMENT 2" pipe fence corner in
STATE PLANE COORDINATES: N _____ concrete
E _____

ELEVATION — M.S.L. DATUM: _____

THETA ANGLE: _____

FIELD BOOK: _____

PAGE _____


CORNER NO. 31
SECTION 7
TOWN 6 N
RANGE 2 W

BASIS FOR MONUMENT LOCATION

(Use reverse side if necessary)

Show info such as: History of corner, with reference to Vol. and pg., dates, surveyor; exact description of monument replaced; if location computed, by taped or EDM traverse; landowner, remarks, etc.

Existing physical evidence accepted and checked with double proportionate measurement.

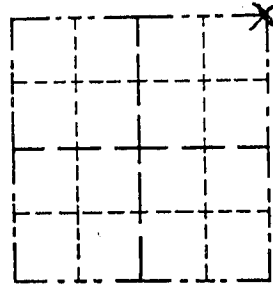


LOCATION
(Indicated by "X")



SEAL:

JAN 10 1983

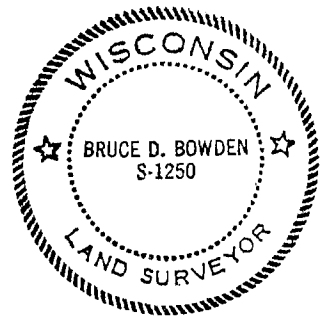

REVISED 12-15-93 BDB

CERTIFIED CORRECT

Bruce D. Bowden
Registered Land Surveyor


DATE: AUGUST 3, 1983

TIE SKETCH

Show at least three (3) ties and monument

LEGEND

- 2" pipe found in concrete
- 7/8" x 24" round, solid, steel rod - set
- *** Fence

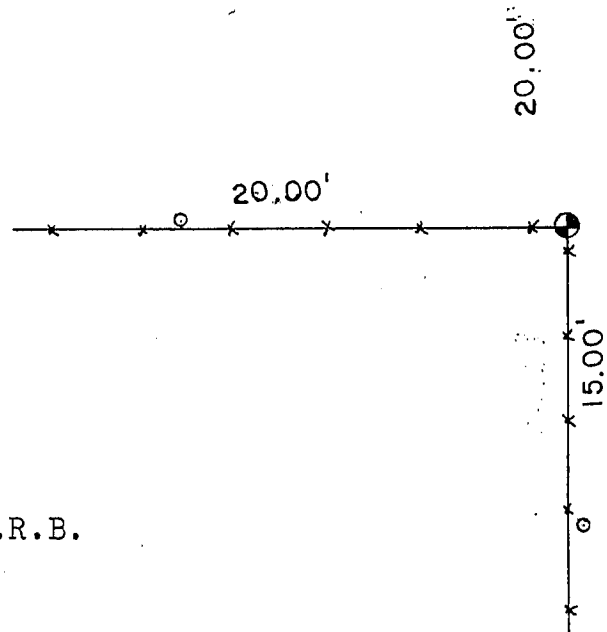

SCALE: 1" = 10'

Drawn by F.R.B.