


Survey Monument Record

CORNER NO. 51
 SECTION 18
 TOWN 6N
 RANGE 2W

TYPE OF MONUMENT 3/4" x 24" iron rod
 STATE PLANE COORDINATES: N _____
 E _____
 ELEVATION — M.S.L. DATUM: _____
 THETA ANGLE: _____
 FIELD BOOK: _____
 PAGE _____

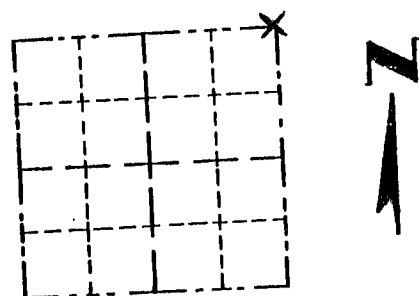

LOCATION
(Indicated by "X")

BASIS FOR MONUMENT LOCATION

(Use reverse side if necessary)

Show info such as: History of corner, with reference to Vol. and pg., dates, surveyor; exact description of monument replaced; if location computed, by taped or EDM traverse; landowner, remarks, etc.

SEAL:

Set monument by accepting existing physical evidence and checked it with double proportionate measurement after an EDM survey of the section.


CERTIFIED CORRECT

Thomas Buck
Registered Land Surveyor

DATE: 2/5/98

TIE SKETCH

Show at least three (3) ties and monument

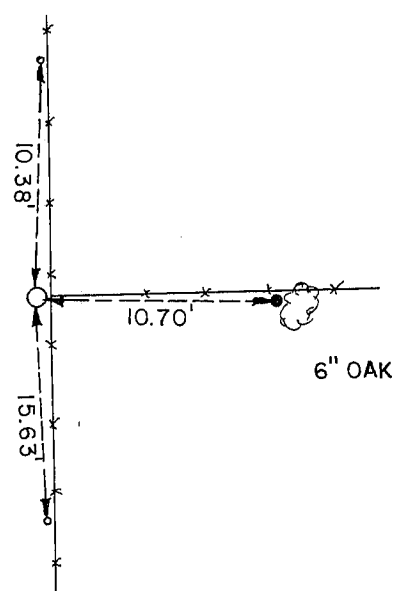

- o = PK NAIL IN WOOD POST
- = 5/8" X 18" IRON ROD
- = 3/4" X 24" IRON ROD
- * * = EXISTING FENCE