


GRANT COUNTY

Survey Monument Record

TYPE OF MONUMENT 1 1/2" x 24" pipe
STATE PLANE COORDINATES: N _____
E _____
ELEVATION — M.S.L. DATUM: _____
THETA ANGLE: _____
FIELD BOOK: _____
PAGE _____

CORNER NO. 35
SECTION 7
TOWN 67 N BRB
RANGE 2 W

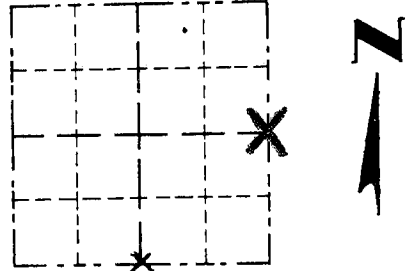

LOCATION
(Indicated by "X")


BASIS FOR MONUMENT LOCATION

(Use reverse side if necessary)

Show info such as: History of corner, with reference to Vol. and pg., dates, surveyor; exact description of monument replaced; if location computed, by taped or EDM traverse; landowner, remarks, etc.

Monument set from existing physical evidence and checked with single proportionate measurement.

SEAL:

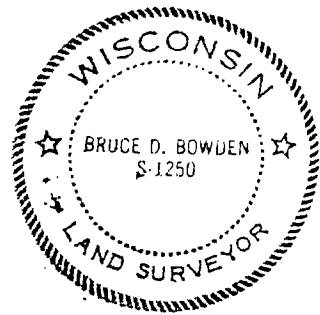

CERTIFIED CORRECT

Bruce D. Bowden
Registered Land Surveyor

DATE: August 3, 1983

TIE SKETCH

Show at least three (3) ties and monument

