

# U.S. PUBLIC LAND SURVEY MONUMENT RECORD

Section 34, Town 6 North Range 2 West, Town of Fennimore, Grant County, Wisconsin

## CERTIFICATE

I, Larry L. Austin, do hereby certify that the corner location on this record was determined by me and/or under my direct supervision and that this U.S. public land survey monument record is correct and complete to the best of my knowledge and belief.

*Larry L. Austin*  
Larry L. Austin, S-1903



● = CORNER LOCATION

## HISTORY OF CORNER


Corner was originally set in 1833 by Parke. No other record of the corner was found.

## CORNER EVIDENCE FOUND

I set the corner at an occupied location. I accepted this location after an EDM & GPS traverse of the area.

**DESCRIPTION OF CORNER AND WITNESS MONUMENTS,** references and accessories used to perpetuate the original or re-established location of this corner. Witnesses to monument location Bobby Sedgwick & Brad Digman & Shelby Blindert

## SKETCH:

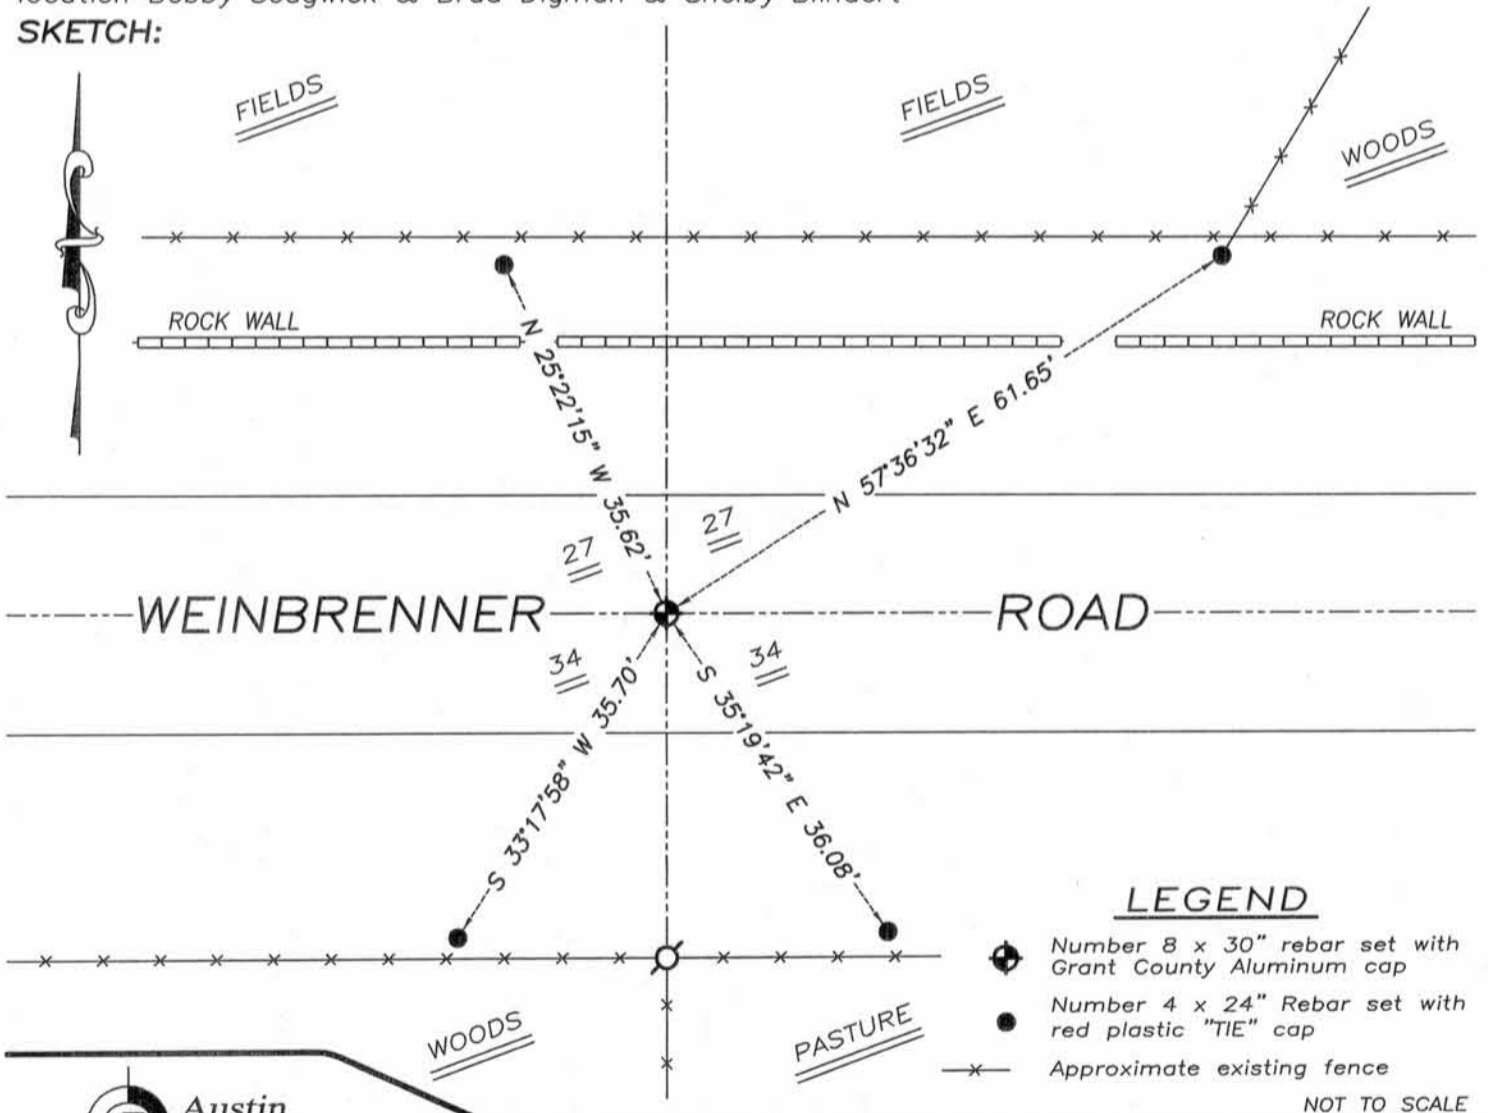

## LEGEND

- Number 8 x 30" rebar set with Grant County Aluminum cap
- Number 4 x 24" Rebar set with red plastic "TIE" cap
- x- Approximate existing fence

NOT TO SCALE



**Austin Engineering LLC**  
austinengineeringllc.com

4211 HWY 81 E, LANCASTER, WI 53813  
PHONE: 608-723-6363 FAX: 608-723-6702

JOB NUMBER 10S049-TREFZ  
FIELDBOOK: TDSR, 10-00  
G:\T6NR2W\29  
H:\TIE\T6NR2W\106

DRAWN BY: SW AUSTIN  
APPROVED: LL AUSTIN

106

NOV 19 2010