

U.S. PUBLIC LAND SURVEY MONUMENT RECORD - GRANT COUNTY, WI


Section 31, Town 6 North Range 2 West, Town of Fennimore

CERTIFICATE:

I, Aaron J. Austin, do hereby certify that the corner location on this record was determined by me and/or under my direct supervision and that this U.S. Public Land Survey Monument Record is correct and complete to the best of my knowledge and belief.

Dated this 15 day of August, 2013.

Aaron J. Austin
 Aaron J. Austin, S-2922

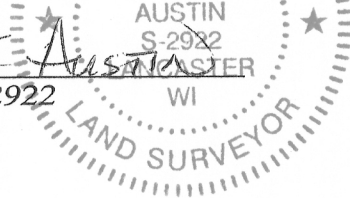


● = CORNER LOCATION

GRANT COUNTY COORDINATES: N=561600.78 E=833698.67

HISTORY OF CORNER ESTABLISHMENT:


Corner was not originally set.

DESCRIPTION OF CORNER EVIDENCE FOUND:

Corner was established by intersecting the North-South 1/4 line with the East-West 1/4 line. County Coordinates were established on this corner by utilizing E.D.M. and G.P.S. methods.

DESCRIPTION OF CORNER AND WITNESS MONUMENTS, references and accessories used to perpetuate the original or re-established location of this corner. Witnesses to corner location Shane Austin

SKETCH:

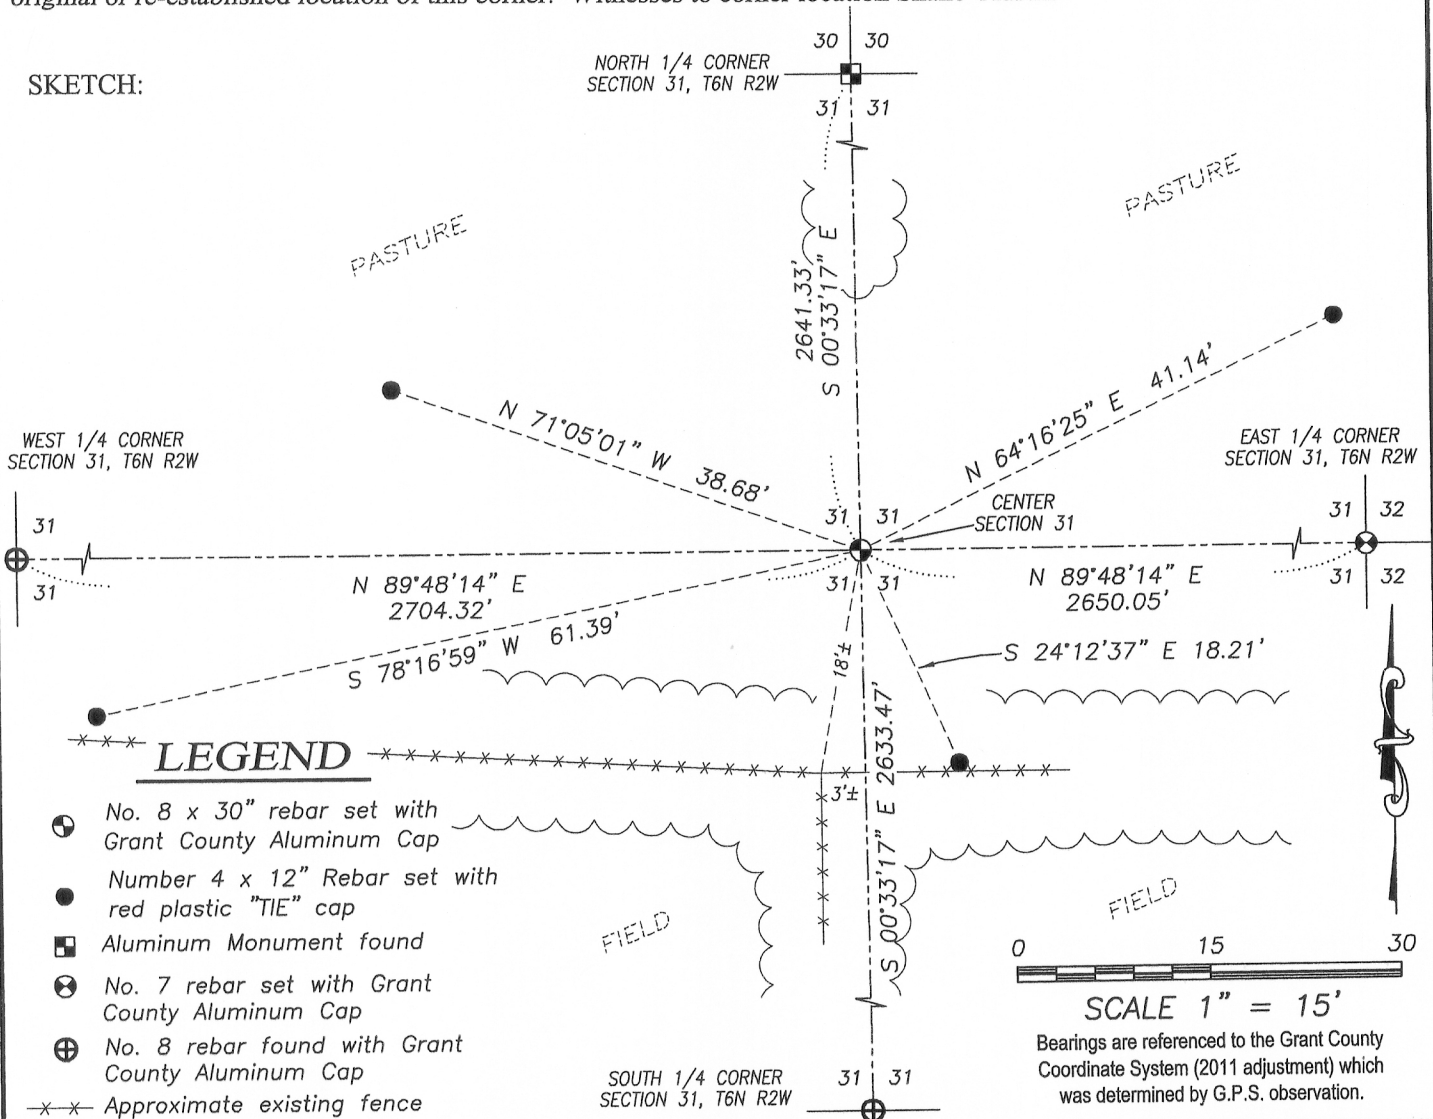

4211 HWY 81 E, LANCASTER, WI 53813
 PHONE: 608-723-6363 FAX: 608-723-6702

JOB NO: 11S192
 G:\GRANTDOT\HWY61B
 H:\TIE\T6NR2W\114.5

FIELDBOOK: TDSR
 DRAWN BY: SW AUSTIN
 CREW: SWA

114.5

AUG 15 2013