


# U.S. PUBLIC LAND SURVEY MONUMENT RECORD

Section 35, Town 6 North Range 2 West, Town of Fennimore, Grant County, Wisconsin

## CERTIFICATE

I, Larry L. Austin, do hereby certify that the corner location on this record was determined by me and/or under my direct supervision and that this U.S. public land survey monument record is correct and complete to the best of my knowledge and belief.

*Larry L. Austin*  
Larry L. Austin, S-1903

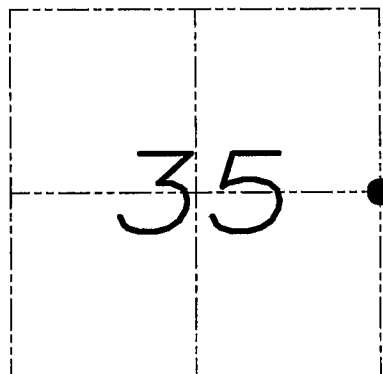

● = CORNER LOCATION

## HISTORY OF CORNER


Corner was originally set by Parke. In 1996 Bowden set and tied this corner. No other record of the corner was found.

## CORNER EVIDENCE FOUND

I found two of Bowden's ties and no monument. I reset the corner based on the two ties as shown below. Verified this location using EDM & GPS methods.

DESCRIPTION OF CORNER AND WITNESS MONUMENTS, references and accessories used to perpetuate the original or re-established location of this corner. Witnesses to monument location Bobby Sedgwick & Brad Digman & Shelby Blindert

## SKETCH:

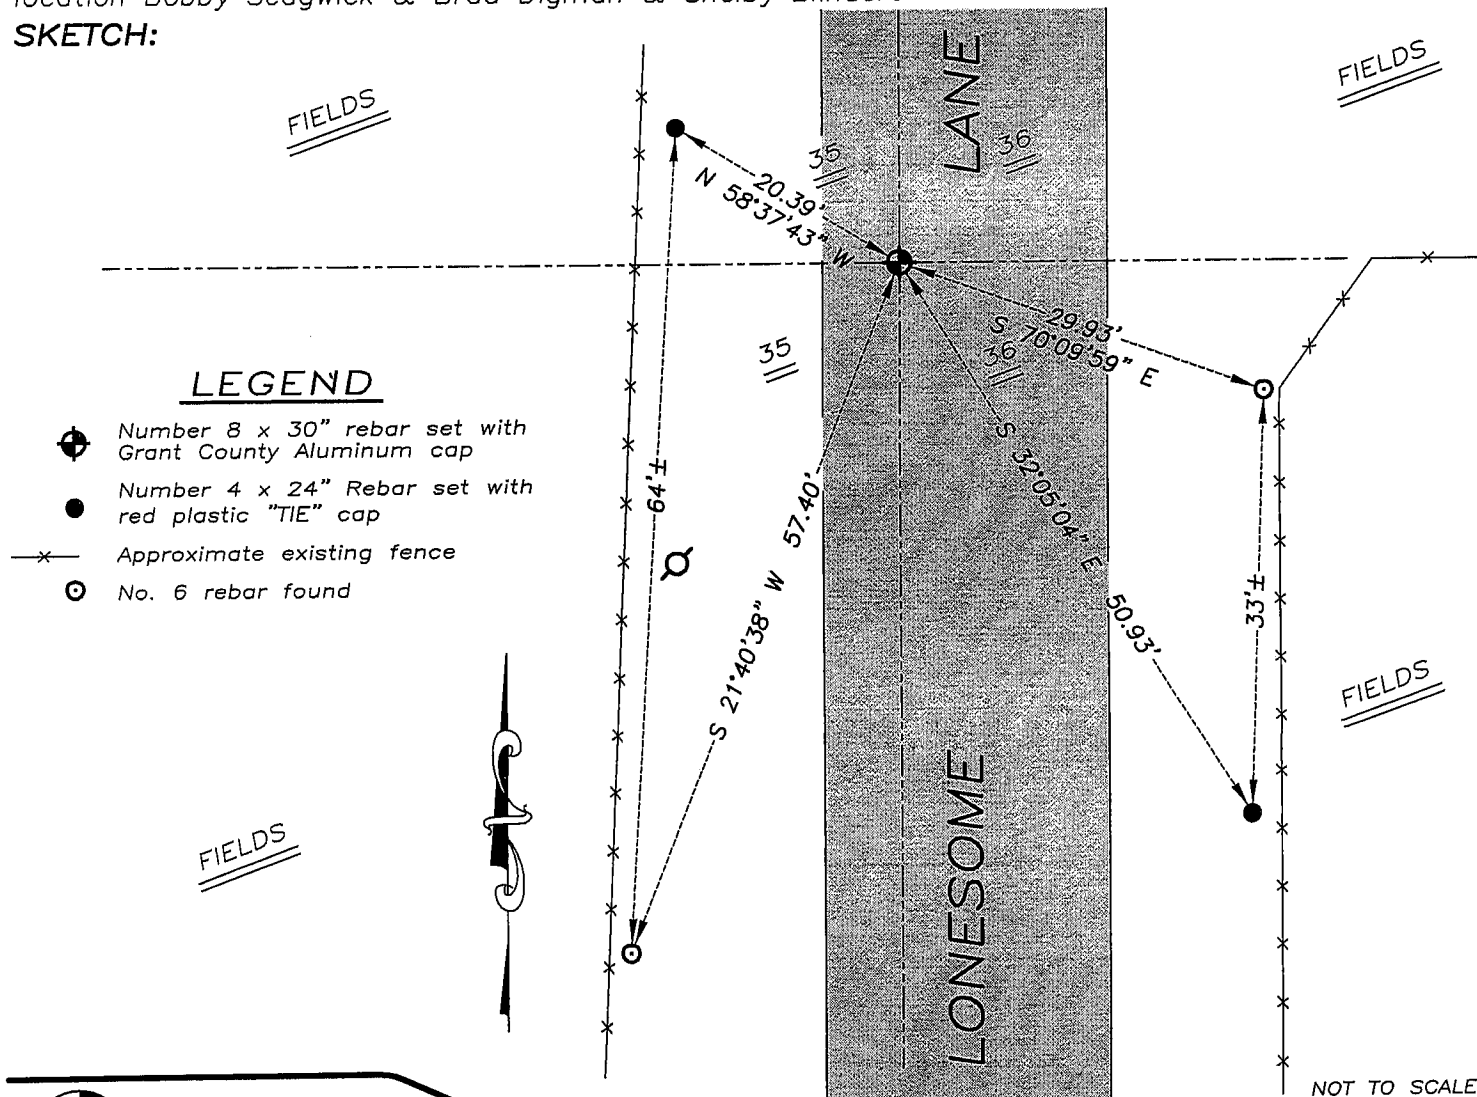

## LEGEND

- ⊕ Number 8 x 30" rebar set with Grant County Aluminum cap
- Number 4 x 24" Rebar set with red plastic "TIE" cap
- x- Approximate existing fence
- No. 6 rebar found

NOT TO SCALE



**Austin Engineering LLC**

4211 HWY 81 E, LANCASTER, WI 53813  
PHONE 608-723-6363 FAX 608-723-6702

JOB NUMBER 075323  
FIELDBOOK: TDSR, 2707  
G:\T5NR2W\02  
H:\TIE\T6NR2W\119

DRAWN BY: SW AUSTIN  
APPROVED: LL AUSTIN


119

# U. S. PUBLIC LAND SURVEY MONUMENT RECORD

**INSTRUCTIONS:** This record shall show the location of the corner and shall include all of the following nine elements (a through i).

- (a) Identify the corner by reference to the U.S. public land survey system.  
 ○ = Corner monument restored.

WEST 1/4 CORNER  
 SECTION 36  
 TOWN 6 NORTH  
 RANGE 2 WEST  
 FENNIMORE TOWNSHIP  
 GRANT COUNTY, WI.

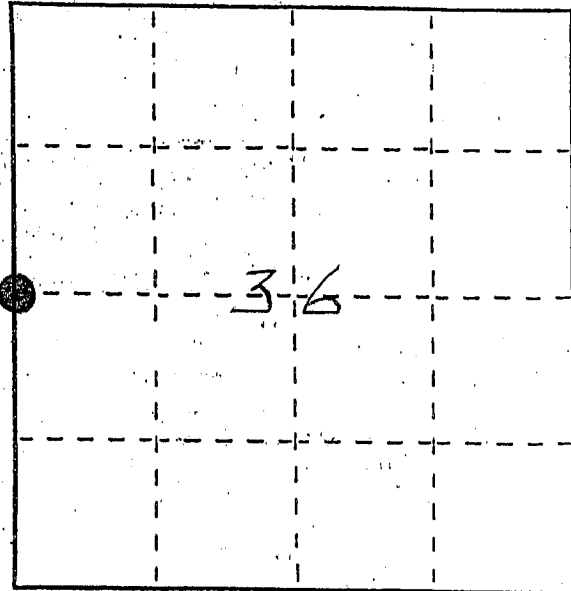


- (b) Describe any record evidence, monument evidence, occupational evidence, testimonial evidence or any other material evidence you considered, and whether the monument was found or placed.

MONUMENT SET IN PLACE OF CIRCLE OF ROCKS, ROTTED WOODEN POST, AND SCRAP IRON, FROM EXISTING PHYSICAL EVIDENCE OF ROADS AND FENCES AFTER VERIFICATION BY PROPORTIONATE MEASUREMENTS FROM A GPS AND EDM SURVEY OF THE AREA.

- (c) In the plan view drawing below, provide reference ties to at least 4 witness monuments, or, if the location is within a municipality, to at least 2 witness monuments. (Witness monuments shall be made of concrete, natural stone, iron or other equally durable material, ~~except~~ wood.) Describe witness monuments.

- (d) Show a plan view drawing depicting the relevant monuments and reference ties which is sufficient in detail to enable accurate relocation of the corner monument if the corner monument is disturbed. Indicate north.

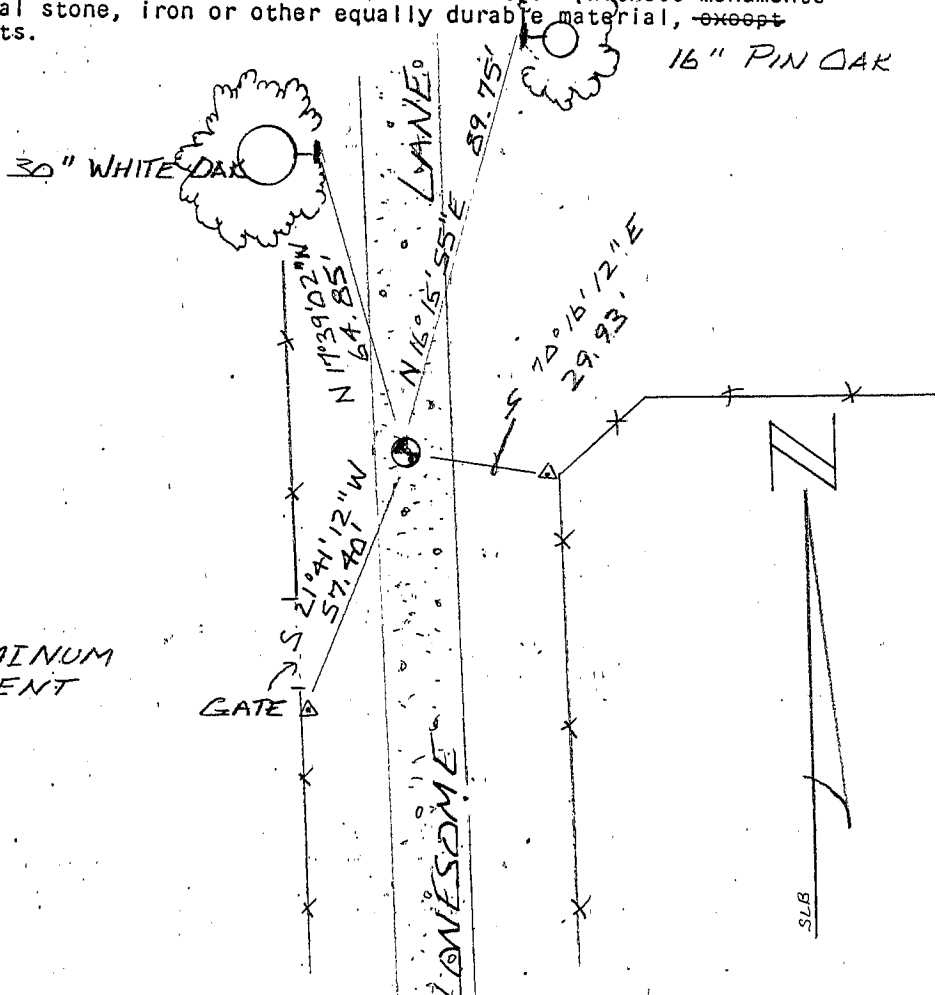

**LEGEND**

- △ #6 X 24" REBAR
- ┴ RAILROAD SPIKE
- × × FENCELINE
- GRAVEL
- ⊙ - GRANT COUNTY ALUMINUM MONUMENT

