

Mr. Ode

RECORD OF CORNER MONUMENTATION


S 1/4 CORNER, SECTION 4 TOWNSHIP 6 N., RANGE 3 W,
GRANT COUNTY, WISCONSIN.

STATE PLANE COORDINATES OF _____
(Y) NORTH _____ ELEVATION _____
(X) EAST _____


HORIZONTAL DATUM: WISCONSIN STATE PLANE COORDINATE SYSTEM, SOUTH ZONE



SKETCH OF CORNER REFERENCE TIES

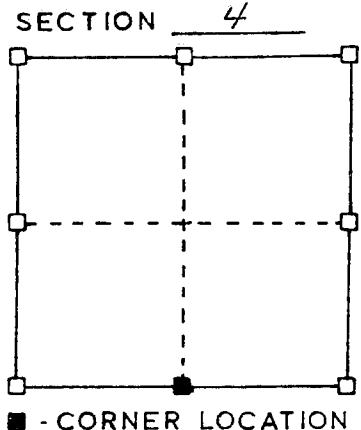


TYPE OF MONUMENT: 1" Ø Iron Pipe

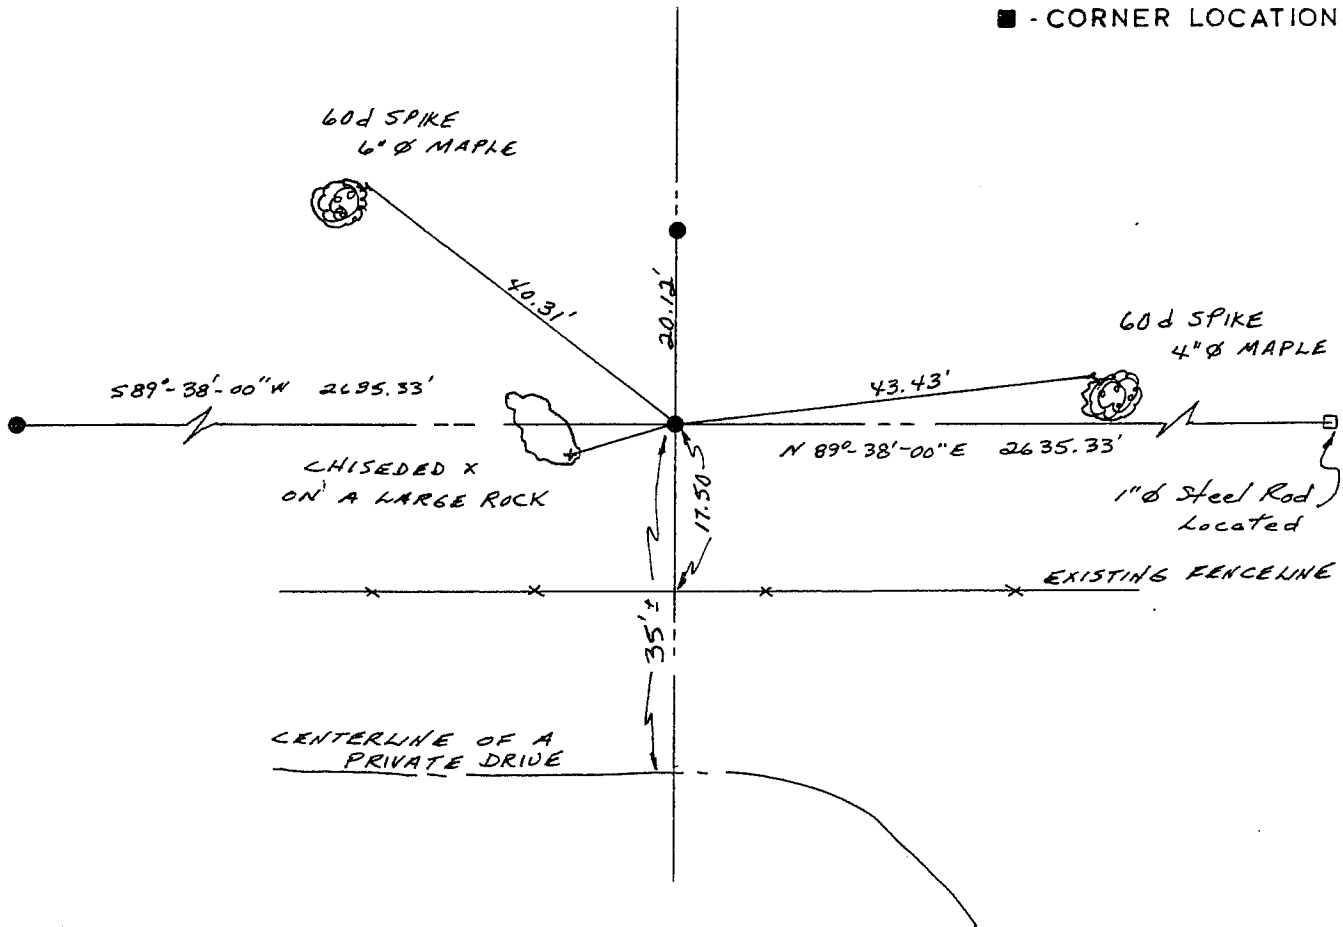

SURVEYOR'S CERTIFICATE
STATE OF WISCONSIN }
Grant County)

I HEREBY CERTIFY THAT I have located the above corner and taken the reference ties as shown to perpetuate the corner. The above location is to the best of my knowledge and belief correct.

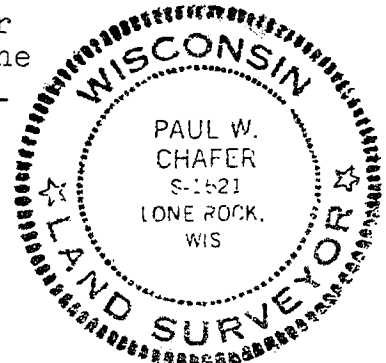

DATED THIS 19 DAY OF Dec
1985

Paul W. Chafer
REGISTERED LAND SURVEYOR
S-1521

JAN 2

