


Survey Monument Record

CORNER NO. 51
SECTION 17
TOWN 6N
RANGE 3W

TYPE OF MONUMENT 3/4" x 24" IRON BAR SET
STATE PLANE COORDINATES: N W/ CAP
E _____

ELEVATION — M.S.L. DATUM: _____
THETA ANGLE: _____
FIELD BOOK: 95-11
PAGE 31

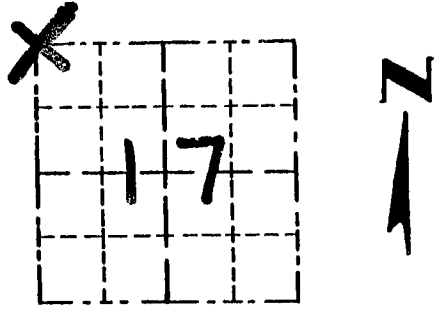

LOCATION
(Indicated by "X")


BASIS FOR MONUMENT LOCATION

(Use reverse side if necessary)

- ORIGINAL CORNER SET
IN 1833 BY HARVEY PARKE

SEAL:

I USED OCCUPATIONAL EVIDENCE IN RE-ESTABLISHING THE LOCATION OF THIS CORNER; E-W LOCATION BASED ON EXISTING N-S FENCE; N-S LOCATION WAS BASED ON THE PROJECTION OF A FENCE FROM THE WEST. I ACCEPTED THIS AS THE CORNER LOCATION AFTER VERIFICATION BY EDM TRAVERSE.

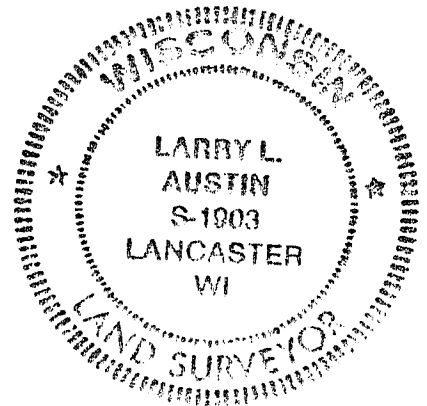

CERTIFIED CORRECT

Larry L. Austin
Registered Land Surveyor

DATE: 2/2/96

TIE SKETCH

Show at least three (3) ties and monument

