


Survey Monument Record

TYPE OF MONUMENT 3/4" X 24" IRON
BAR SET AT CORNER

CORNER NO. 52
SECTION 07
TOWN 6N
RANGE 3W

FIELD BOOK: 97-10
PAGE (2)

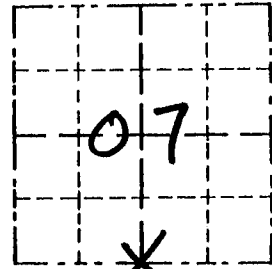

LOCATION
(Indicated by "X")


BASIS FOR MONUMENT LOCATION

(Use reverse side if necessary)

Show info such as: History of corner, with reference to Vol. and pg., dates, surveyor; exact description of monument replaced; if location computed, by taped or EDM traverse; landowner, remarks, etc.

SEAL:

CORNER WAS SET IN 1833 BY HARVEY PARKE. NO RECORD OF CORNER FOUND SINCE ORIGINAL SURVEYS. THE CORNER WAS RESET BY PROPORTIONATE MEASUREMENTS ALONG THE SOUTH LINE OF SEC. 7

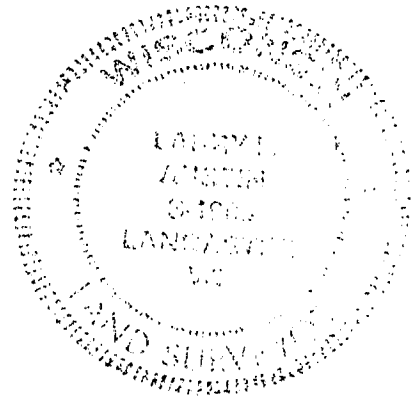

CERTIFIED CORRECT

Ray F. Rust
Registered Land Surveyor

DATE: 4/10/98

TIE SKETCH

Show at least three (3) ties and monument

LEGEND

⊕ 3/4" X 24" IRON BAR SET

○ 1/2" X 15" IRON BAR SET

** EXISTING FENCE

