

REC'D MAR 8 1996

Survey Monument Record

CORNER NO. 49
SECTION 17
TOWN 6N
RANGE 3W

TYPE OF MONUMENT 2" PIPE POST SET IN CONC.


STATE PLANE COORDINATES: N _____
E _____

ELEVATION — M.S.L. DATUM: _____

THETA ANGLE: _____

FIELD BOOK: 95-11

PAGE 31

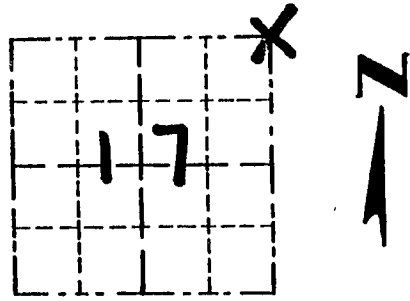

LOCATION
(Indicated by "X")


BASIS FOR MONUMENT LOCATION

(Use reverse side if necessary)

- ORIGINAL CORNER SET
IN 1833 BY HARVEY PARKE

SEAL:

FOUND A 2" PIPE POST IN
AN EXISTING N-S FENCE;
THIS WAS USED BY BOWDEN FOR
VERIFICATION IN 1992; I ACCEPTED
THIS AS THE CORNER LOCATION
AFTER VERIFICATION BY EDM
TRAVERSE OF THE AREA.

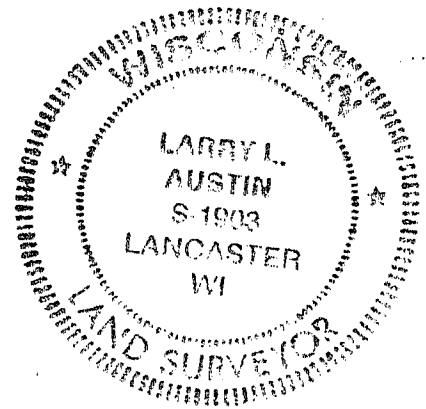

CERTIFIED CORRECT

Larry L. Austin
Registered Land Surveyor

DATE: 2/2/96

TIE SKETCH

Show at least three (3) ties and monument

LEGEND

● 2" PIPE POST SET IN CONC.

○ 1" x 12" IRON PIPE SET

* * * EXISTING FENCE FIELD

