

RECD MAR 8 1996

Survey Monument Record

TYPE OF MONUMENT 3/4" X 24" IRON BAR SET

STATE PLANE COORDINATES: N _____
E _____


ELEVATION — M.S.L. DATUM: _____

THETA ANGLE: _____

FIELD BOOK: 95-11

PAGE 31

CORNER NO. 50
SECTION 17
TOWN 6N
RANGE 3W

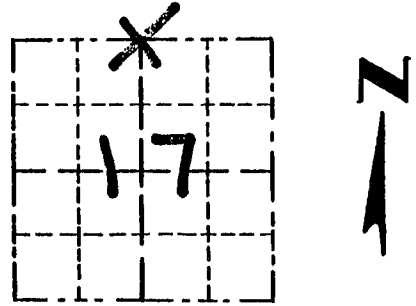

LOCATION
(Indicated by "X")


BASIS FOR MONUMENT LOCATION

(Use reverse side if necessary)

- ORIGINAL CORNER SET IN
1833 B4 HARVEY PARKE

SEAL:

- CORNER WAS RESET AT
EQUIDISTANT BETWEEN THE
NE + NW CORNERS WHICH
MATCHES FENCE PROJECTIONS
FROM EAST; I Accepted this as
THE CORNER AFTER VERIFICATION
BY EDM TRAVERSE OF THE AREA.

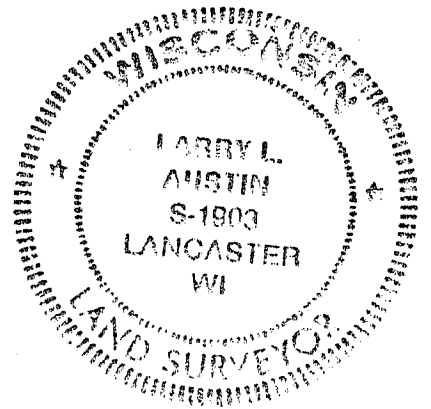


CERTIFIED CORRECT

Larry L. Austin
Registered Land Surveyor

DATE: 2/2/96

TIE SKETCH

Show at least three (3) ties and monument

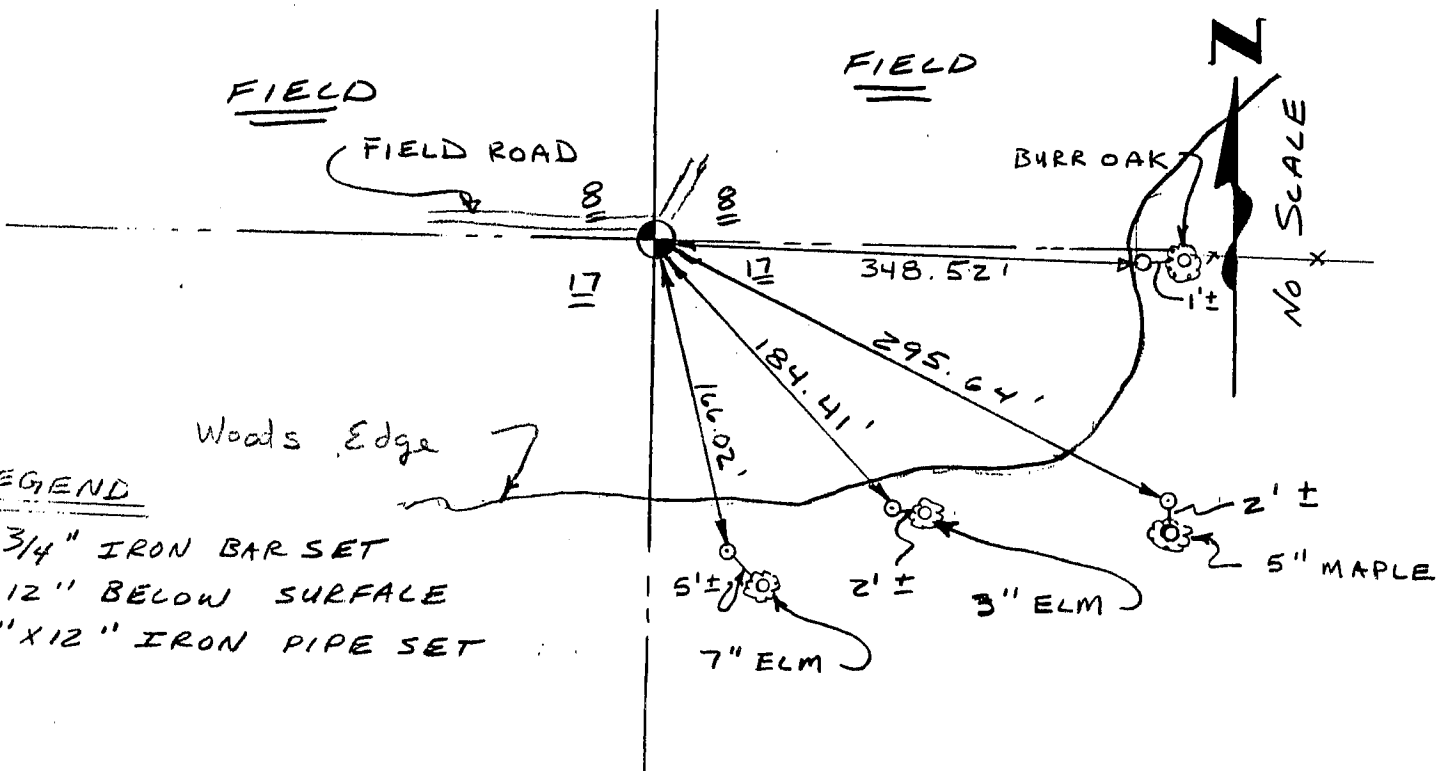

LEGEND

- ⊕ 3/4" IRON BAR SET
12" BELOW SURFACE
- 1" X 12" IRON PIPE SET