

Survey Monument Record

TYPE OF MONUMENT 3/4" x 24" IRON BAR SET

STATE PLANE COORDINATES: N _____
E _____


ELEVATION — M.S.L. DATUM: _____

THETA ANGLE: _____

FIELD BOOK: 95-11

PAGE 29

CORNER NO. 69
SECTION 17
TOWN 6N
RANGE 3W

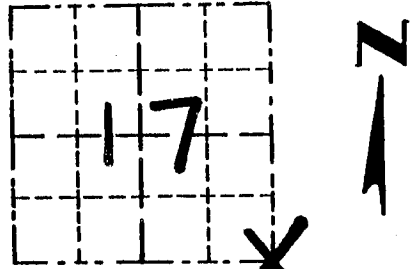


LOCATION
(Indicated by "X")

BASIS FOR MONUMENT LOCATION

(Use reverse side if necessary)

- ORIGINAL CORNER SET
IN 1833 BY HARVEY PARKE.

SEAL:

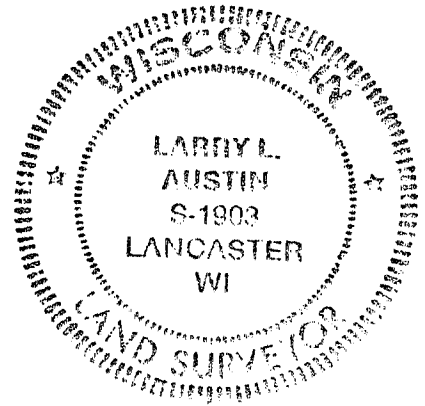

- LOCATION OF CORNER
ESTABLISHED BY PROPORTIONATE
MEASUREMENTS TO THE SE CORNER
OF SECTION 20 AND THE EAST 1/4
CORNER SECTION 17 & VERIFIED BY
EDM TRAVERSE OF AREA.

CERTIFIED CORRECT

Larry L. Austin
Registered Land Surveyor

DATE: 2/2/96

TIE SKETCH

Show at least three (3) ties and monument

LEGEND

- 3/4" x 24" IRON BAR SET
- 1" x 12" IRON PIPE SET
- — — EXISTING FENCE

