

REC'D MAR 8 1996

Survey Monument Record

CORNER NO. 70
SECTION 17
TOWN 6N
RANGE 3W

TYPE OF MONUMENT 3/4" x 24" IRON BAR SET

STATE PLANE COORDINATES: N _____
E _____

ELEVATION — M.S.L. DATUM: _____


THETA ANGLE: _____

FIELD BOOK: 95-11

PAGE 31

BASIS FOR MONUMENT LOCATION


(Use reverse side if necessary)

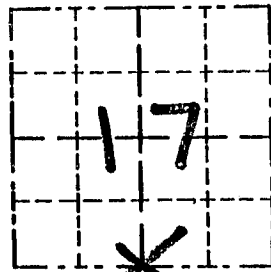

LOCATION
(Indicated by "X")

- ORIGINAL CORNER SET IN 1833 BY HARVEY PARKE SEAL:

- CORNER WAS RESET AT EQUIDISTANT BETWEEN THE SE + SW CORNER & VERIFIED BY EDM TRAVERSE OF THE AREA.

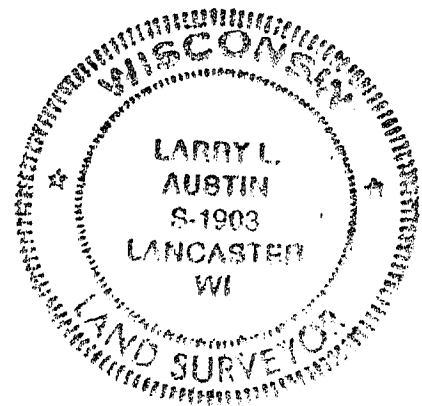


CERTIFIED CORRECT

Larry L. Austin
Registered Land Surveyor

DATE: 2/2/96

TIE SKETCH

Show at least three (3) ties and monument

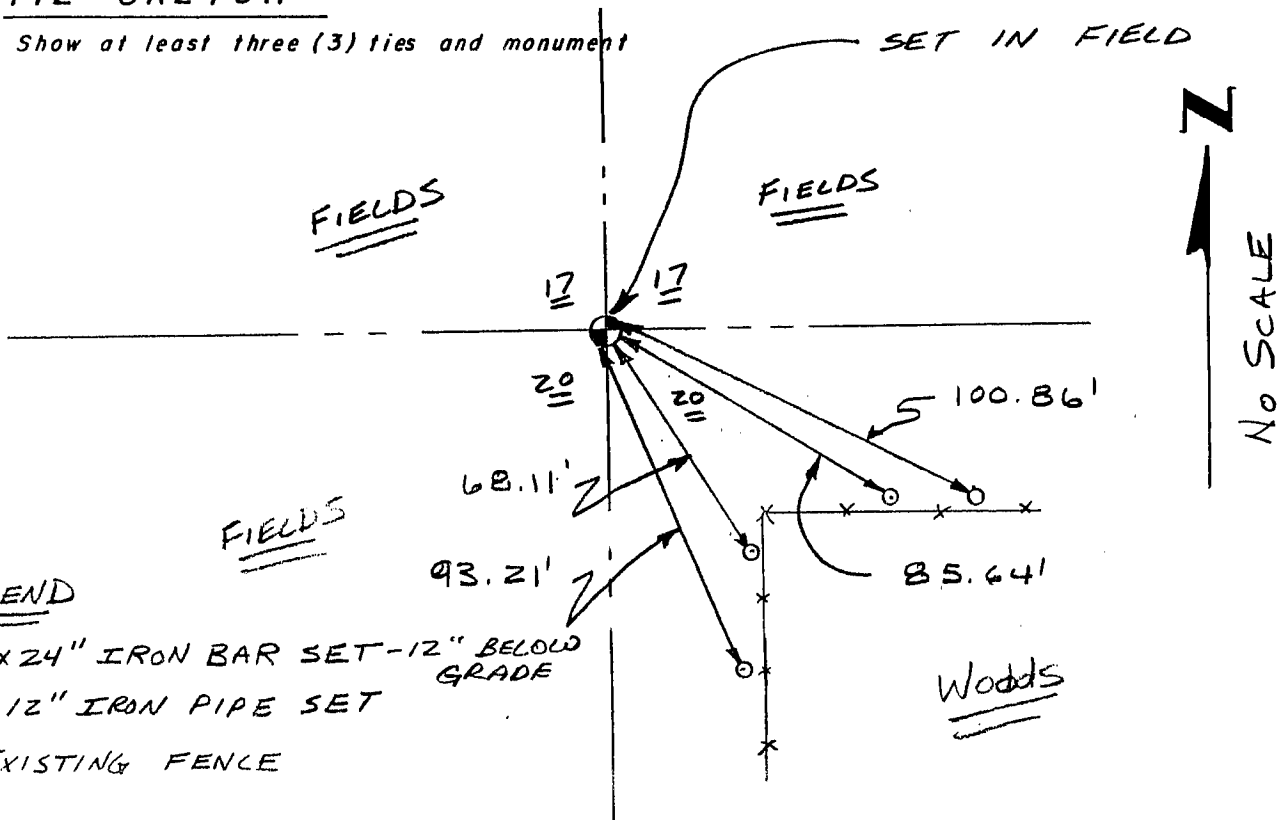

LEGEND

- ⊙ 3/4" x 24" IRON BAR SET - 12" BELOW GRADE
- 1" x 12" IRON PIPE SET
- X-X- EXISTING FENCE