

REC'D MAR 8 1995

Survey Monument Record

TYPE OF MONUMENT 1" IRON BAR FOUND

STATE PLANE COORDINATES: N \_\_\_\_\_  
E \_\_\_\_\_


ELEVATION — M.S.L. DATUM: \_\_\_\_\_

THETA ANGLE: \_\_\_\_\_

FIELD BOOK: 95-11

PAGE 29

CORNER NO. 56  
SECTION 17  
TOWN 6N  
RANGE 3W

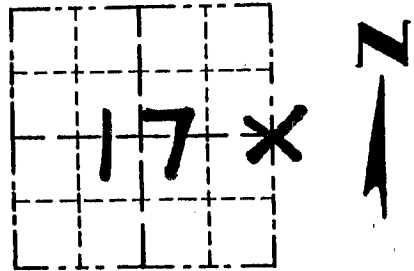


LOCATION  
(Indicated by "X")

BASIS FOR MONUMENT LOCATION

(Use reverse side if necessary)

- ORIGINAL CORNER SET IN 1833 BY HARVEY PARKE.
- FOUND A 1" BAR AT AN OCCUPATION EVIDENCE LOCATION <sup>SEAL:</sup>
- I ACCEPTED THIS LOCATION AFTER VERIFICATION BY EDM TRAVERSE OF THE AREA.

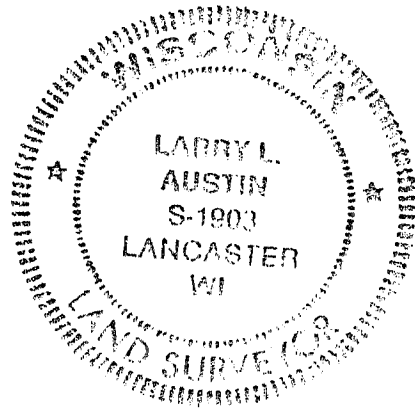

CERTIFIED CORRECT

*Larry L. Austin*  
Registered Land Surveyor

DATE: 2/2/96

TIE SKETCH

Show at least three (3) ties and monument

