


REC'D MAR 8 1996

Survey Monument Record

TYPE OF MONUMENT 3/4" x 24" IRON BAR SET 12"
STATE PLANE COORDINATES: N BELOW SURFACE
E _____

CORNER NO. 55
SECTION 17
TOWN 6N
RANGE 3W

ELEVATION — M.S.L. DATUM: _____
THETA ANGLE: _____
FIELD BOOK: 95-11
PAGE 30

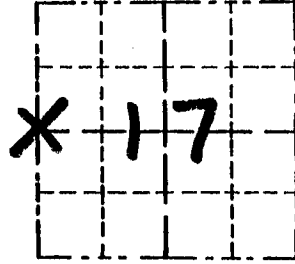

LOCATION
(Indicated by "X")


BASIS FOR MONUMENT LOCATION

(Use reverse side if necessary)

- ORIGINAL CORNER SET
IN 1833 BY HARVEY PARKE.

SEAL:

- CORNER WAS RESET AT
EQUIDISTANT BETWEEN
THE NW + SW CORNER &
VERIFIED BY EDM TRAVERSE
OF AREA.

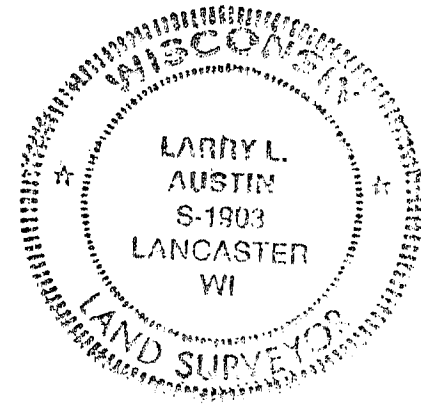

CERTIFIED CORRECT

Larry L. Austin
Registered Land Surveyor

DATE: 2/2/96

TIE SKETCH

Show at least three (3) ties and monument

LEGEND

- ⊕ 3/4" x 24" IRON BAR SET 12" BELOW SURFACE
- 1" x 12" IRON PIPE SET
- TOP OF EAST MOST BOLT SOUTH WEST CORNER BRIDGE 146.15'
- EXISTING FENCE

