


REC'D MAR 8 1995

Survey Monument Record

CORNER NO. 76
SECTION 20
TOWN 6N
RANGE 3W

TYPE OF MONUMENT COUNTY Monument (3/4" x 24" IRON
STATE PLANE COORDINATES: N BAR W/ CAP)
E _____

ELEVATION — M.S.L. DATUM: _____
THETA ANGLE: _____
FIELD BOOK: 95-11
PAGE (29)

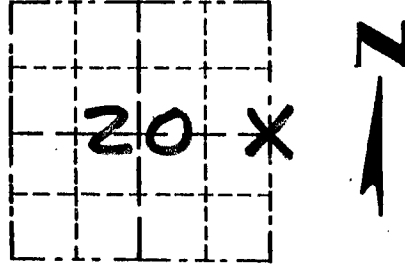

LOCATION
(Indicated by "X")


BASIS FOR MONUMENT LOCATION

(Use reverse side if necessary)

- ORIGINAL CORNER SET IN'
1833 BY HARVEY PARKE

SEAL:

- E-W LOCATION BASED ON
A N-S FENCE OCCUPATION
LOCATION; THE N-S LOCATION
BASED ON PROPORTIONATE
MEASUREMENTS TO THE SE
CORNER OF SECTION 20 AND
THE EAST 1/4 CORNER SECTION
17 & VERIFIED BY EDM
TRAVERSE OF THE AREA.

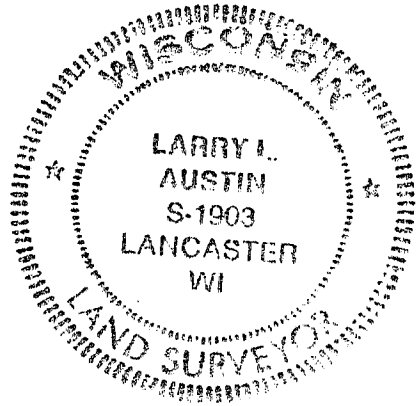

CERTIFIED CORRECT

Larry L. Austin
Registered Land Surveyor

DATE: 2/2/96

TIE SKETCH

Show at least three (3) ties and monument

