


U. S. PUBLIC LAND SURVEY MONUMENT RECORD

INSTRUCTIONS: This record shall show the location of the corner and shall include all of the following nine elements (a through i).

(a) Identify the corner by reference to the U.S. public land survey system.

○ = Corner monument restored.

THE SOUTH QUARTER CORNER:
SECTION 23.
TOWN 6 NORTH,
RANGE 3 WEST
MT. IDA TOWNSHIP
GRANT COUNTY,
WISCONSIN.

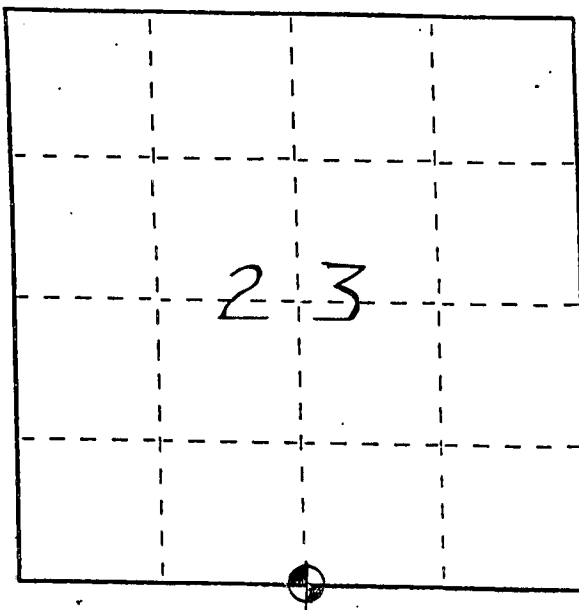


(b) Describe any record evidence, monument evidence, occupational evidence, testimonial evidence or any other material evidence you considered, and whether the monument was found or placed.

FOUND & ACCEPTED NO. 6 REBAR AS CALLED FOR IN AN AUGUST 1, 1984 TIE SHEET. SET 2 TIES AS SHOWN BELOW.

(c) In the plan view drawing below, provide reference ties to at least 4 witness monuments, or, if the location is within a municipality, to at least 2 witness monuments. (Witness monuments shall be made of concrete, natural stone, iron or other equally durable material) Describe witness monuments.

(d) Show a plan view drawing depicting the relevant monuments and reference ties which is sufficient in detail to enable accurate relocation of the corner monument if the corner monument is disturbed. Indicate north.

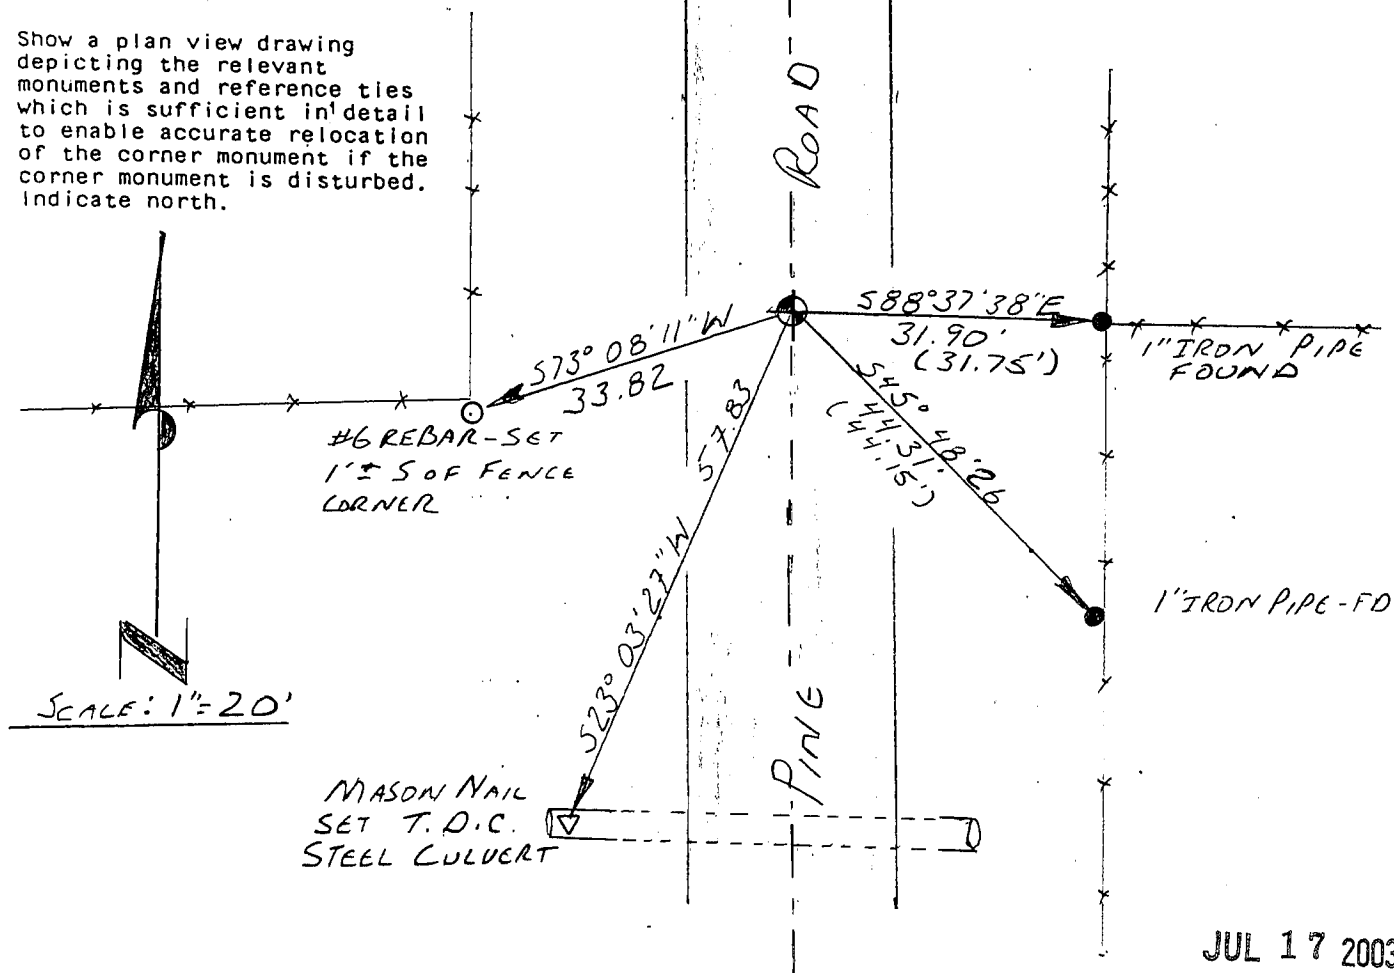

- (e) Describe any material discrepancy between the location of the corner as restored or reestablished and the location of that corner as previously restored or reestablished by distance and direction. Show the discrepancy on the plan view drawing under (d), above. Show the distances between the corner as previously restored or reestablished and (1) the corner as restored or reestablished, and (2) to at least 2 of the witness monuments shown on the drawing in (d), above.

N. A.

- (f) Was the corner restored through acceptance of (1) an obliterated evidence location, or, (2) a found perpetuated location?

(2) FOUND, PERPETUATED LOCATION


- (g&h) Was the corner reestablished through lost corner proportionate methods? If so, show the method, including the directions and distances to other public land survey corners used as evidence or used for proportioning in determining the corner location?

No

- (i) I, Bruce D. Bowden
(type or print name) certify that the corner location shown on this record was determined by me or under my direction and control and that this U.S. Public Land Survey Monument Record is correct and complete to the best of my knowledge and belief.

Signature

Date

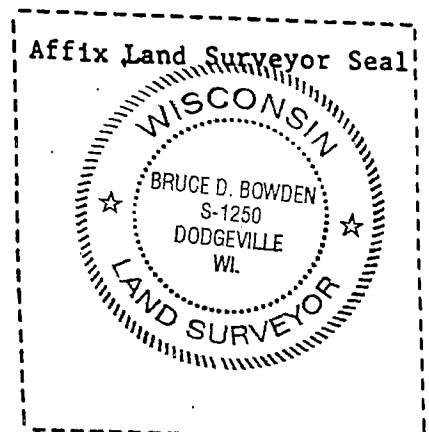

Bruce D. Bowden July 14, 2003

MA. Ida Twp.


GRANT COUNTY

Survey Monument Record

CORNER NO. 84
SECTION 26
TOWN 6 North
RANGE 3 West

TYPE OF MONUMENT 3/4" x 24" round, solid, iron rod
STATE PLANE COORDINATES: N _____
E _____

ELEVATION — M.S.L. DATUM: _____
THETA ANGLE: _____
FIELD BOOK: _____
PAGE _____

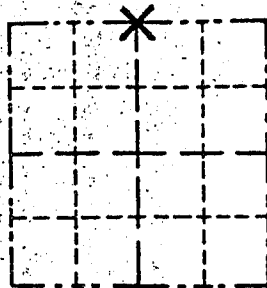

LOCATION
(Indicated by "X")


BASIS FOR MONUMENT LOCATION

(Use reverse side if necessary)

Show info such as: History of corner, with reference to Vol. and pg., dates, surveyor; exact description of monument replaced; if location computed, by taped or EDM traverse; landowner, remarks, etc.

SEAL:

Corner set from existing physical evidence and proportionate measurement, as coordinated from an EDM traverse.

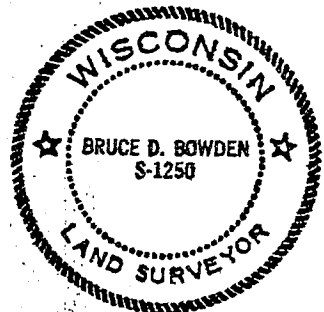


MULTI-TRUNKED
SOFT MAPLE

CERTIFIED CORRECT
Bruce D. Bowden
Registered Land Surveyor
DATE: August 1, 1984

TIE SKETCH

Show at least three (3) ties and monument

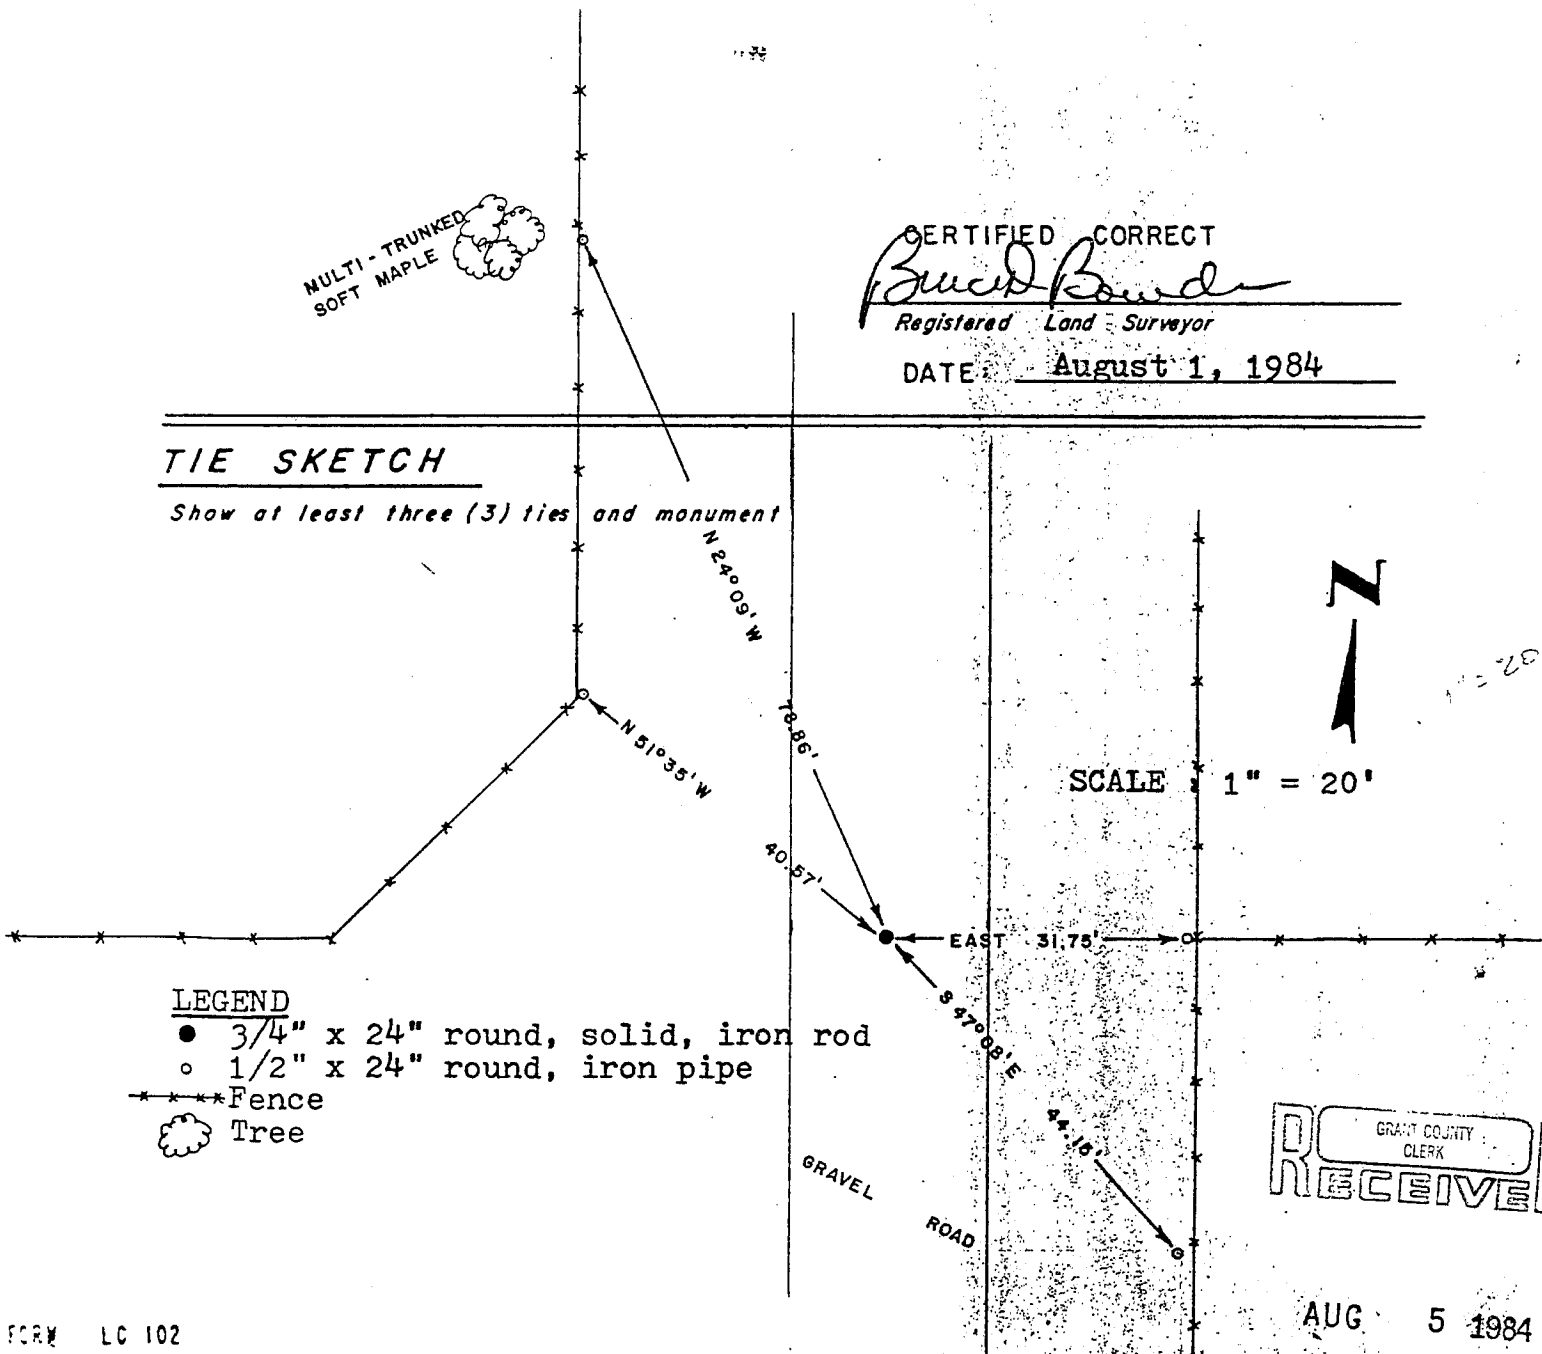

LEGEND

● 3/4" x 24" round, solid, iron rod
○ 1/2" x 24" round, iron pipe

***** Fence

Tree

GRANT COUNTY CLERK
RECEIVED

AUG 5 1984