

DEC 11 2000

GRANT COUNTY CERTIFIED LAND CORNER


CORNER NUMBER 82

CERTIFICATE:


I, Larry L. Austin, do hereby certify that on the 23rd day of December, 1998, I found evidence of the South 1/4 corner of Section 24, Town 6 North, Range 3 West, of the 4th Principal Meridian, and I re-established said corner according to the Wisconsin statutes as shown and described hereon.

Dated this 23rd day of October, 2000

Larry L. Austin
Larry L. Austin S-1903

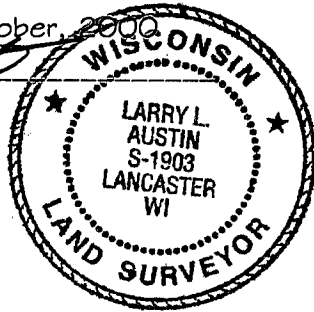

SEAL

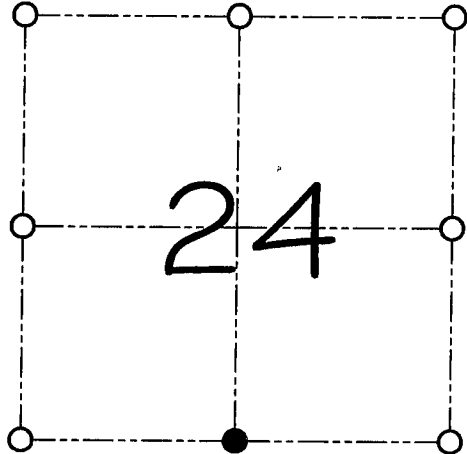

● = CORNER LOCATION

SOUTH 1/4 CORNER OF
SECTION 24, T 6 N R 3 W
TOWN OF MOUNT IDA

HISTORY OF ORIGINAL CORNER ESTABLISHMENT:

Corner was originally set in 1833 by Harvey Parke.
No other record of the corner was found.

DESCRIPTION OF CORNER EVIDENCE FOUND:

I found an existing bearing tree and set the corner based on the tree. Verified this location using E.D.M. & G.P.S. methods.

DESCRIPTION OF CORNER AND WITNESS MONUMENTS, references and accessories used to perpetuate the original or re-established location of this corner

WITNESS TO THE CORNER LOCATION: SHELBY BLINDERT & BOBBY SEDGWICK

SKETCH:

