


M. Ida Twp.

GRANT COUNTY

Survey Monument Record

CORNER NO. 103
 SECTION 26
 TOWN 6 North
 RANGE 3 West

TYPE OF MONUMENT 1 1/2" x 30" round, solid,
iron rod
 STATE PLANE COORDINATES: N _____
 E _____
 ELEVATION — M.S.L. DATUM: _____
 THETA ANGLE: _____
 FIELD BOOK: _____
 PAGE _____

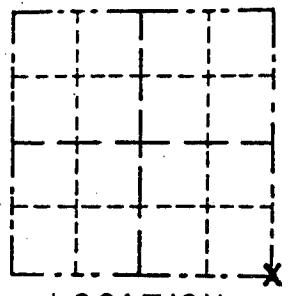

LOCATION
 (Indicated by "X")


BASIS FOR MONUMENT LOCATION

(Use reverse side if necessary)

Show info such as: History of corner, with reference to Vol. and pg., dates, surveyor; exact description of monument replaced; if location computed, by taped or EDM traverse; landowner, remarks, etc.

SEAL:



Corner set from existing physical evidence and verified with proportionate measurement from an EDM traverse.

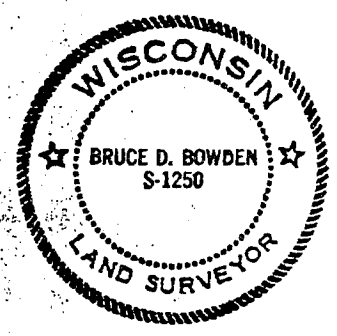

CERTIFIED CORRECT
Bruce D. Bowden
 Registered Land Surveyor
 DATE: August 1, 1984

TIE SKETCH

Show at least three (3) ties and monument

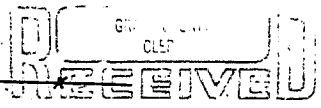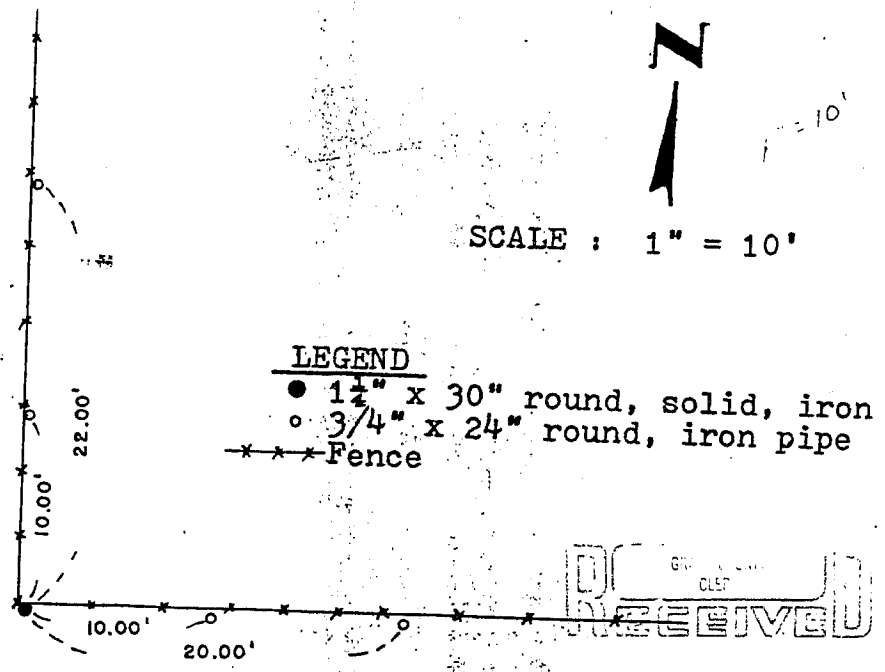

103

Ma. Ida Twp

GRANT COUNTY

Survey Monument Record

CORNER NO. 103
 SECTION 26
 TOWN 6 North
 RANGE 3 West


TYPE OF MONUMENT 1 1/2" x 30" round, solid,
 STATE PLANE COORDINATES: N iron rod
 E _____

ELEVATION — M.S.L. DATUM: _____

THETA ANGLE: _____

FIELD BOOK: _____

PAGE _____

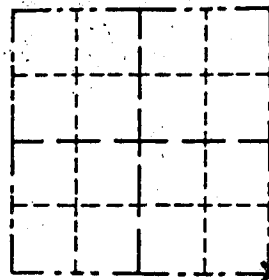

LOCATION
 (Indicated by "X")


BASIS FOR MONUMENT LOCATION

(Use reverse side if necessary)

Show info such as: History of corner, with reference to Vol. and pg., dates, surveyor; exact description of monument replaced; if location computed, by taped or EDM traverse; landowner, remarks, etc.

SEAL:

Corner set from existing physical evidence and verified with proportionate measurement from an EDM traverse.


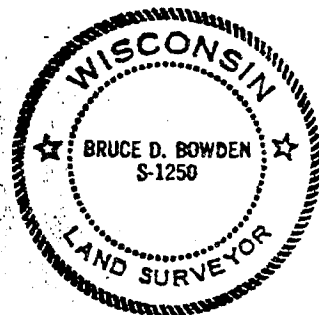


CERTIFIED CORRECT
Bruce D. Bowden
 Registered Land Surveyor

DATE: August 1, 1984

TIE SKETCH

Show at least three (3) ties and monument

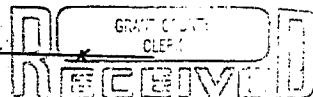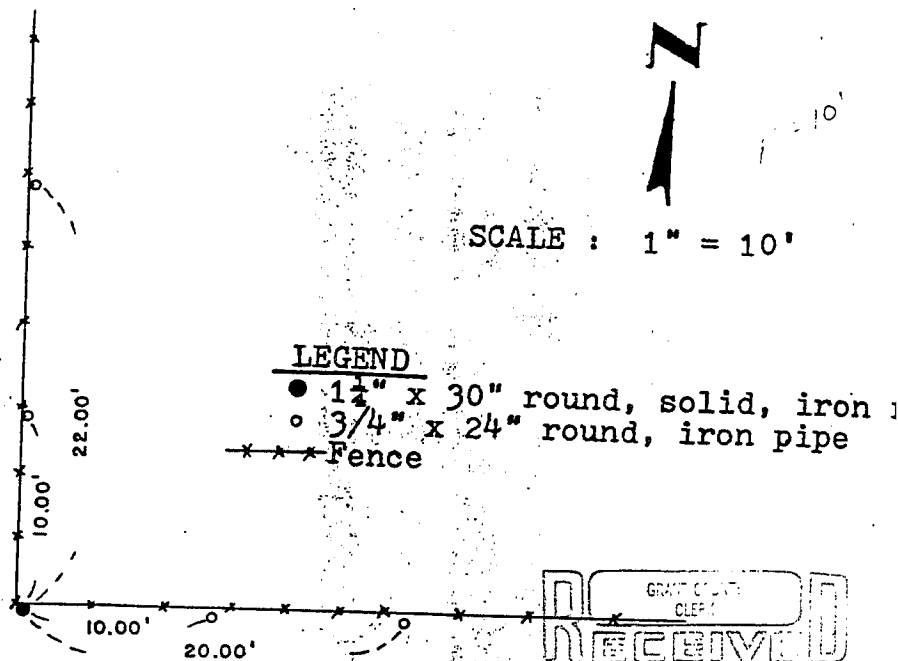

103