

GOVERNMENT CORNER RECORD


Southeast CORNER, SECTION 29, TOWNSHIP 6 NORTH, RANGE 3 EAST - WEST,
 TOWN, CITY OR VILLAGE OF Mt. Ida
 TYPE OF MONUMENT: 3/4" x 24" Iron Rod Set ELEVATION - M.S.L. DATUM _____

WITNESSES TO CORNER LOCATION

SECTION 29, T. 6 N, R. 3 EW


Sean M. Walsh

Scott H. Chyko

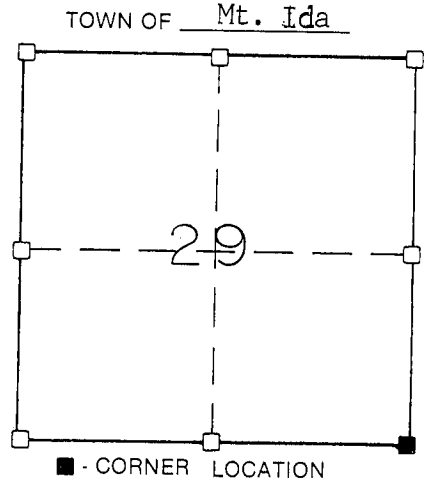

TIE SKETCH
(SHOW ALL HELPFUL FEATURES)

* Ties 60D Pole Spike in blaze as noted.

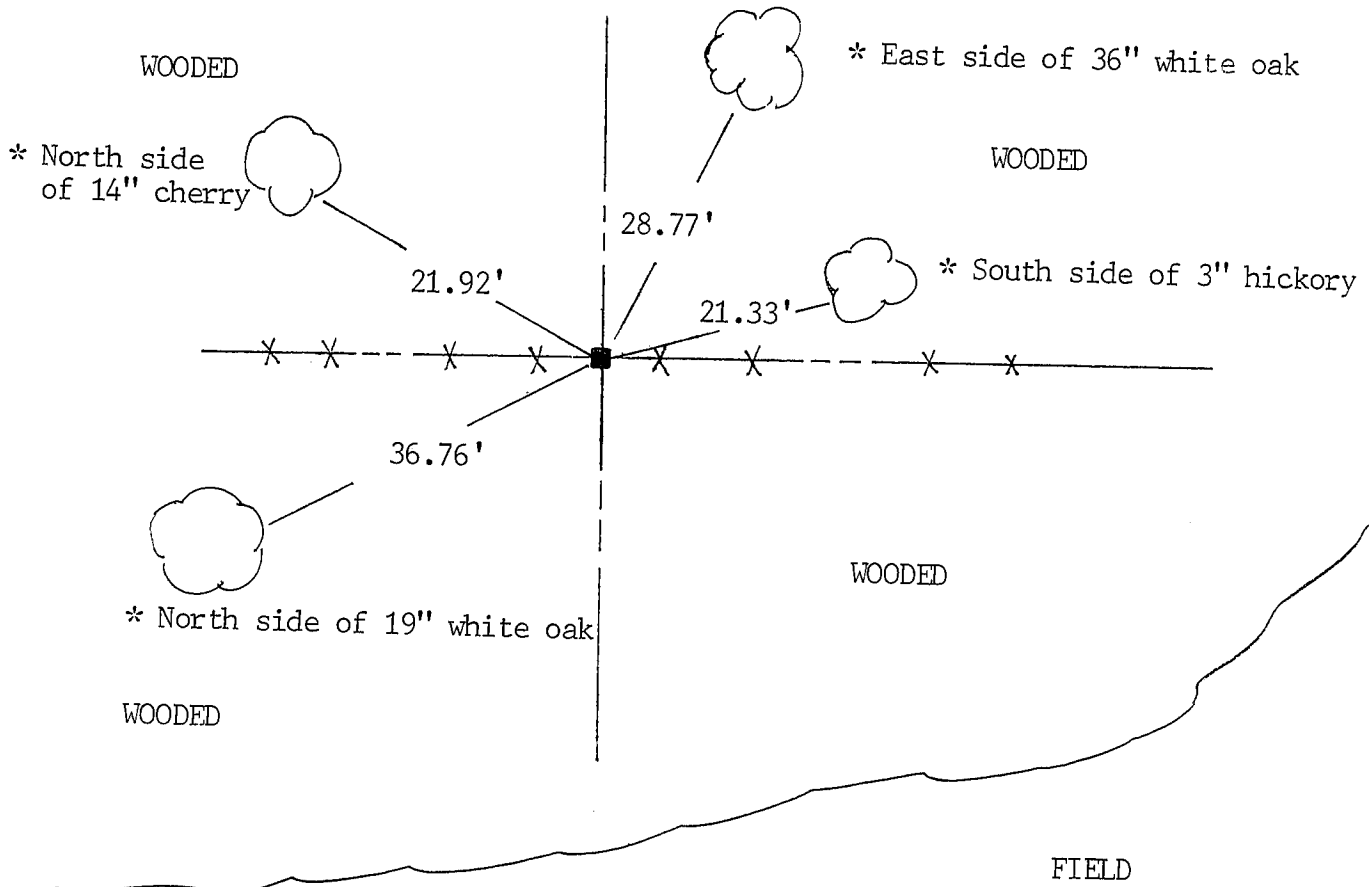

SURVEYOR'S CERTIFICATE

SEAL S- 2016

I, Sean M. Walsh, DO HEREBY CERTIFY THAT I have monumented and
 perpetuated this corner in accordance with the information as shown above
 and that this information is correct and true to the best of my information,
 knowledge and belief. I could not find any evidence of this corner either
 record or physical, other than the East / West occupied fence line and
 some evidence of fence remains running North of this location. Said
 location is on a straight line with the E line of the NE 1/4 at the occupied E/W line.

DATED THIS 23 DAY OF MAY, 19 94

REGISTERED LAND SURVEYOR

