

GRANT COUNTY

Survey Monument Record

CORNER NO. 115
 SECTION 32
 TOWN 6N
 RANGE 3W

TYPE OF MONUMENT GRANT COUNTY ALUMINUM MON.

STATE PLANE COORDINATES: N _____
 E _____


ELEVATION — M.S.L. DATUM: _____

THETA ANGLE: _____

FIELD BOOK: _____

PAGE _____

W 1/4 COR

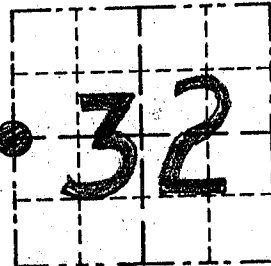

LOCATION
 (Indicated by "•")


SEAL:

BASIS FOR MONUMENT LOCATION

(Use reverse side if necessary)

Show info such as: History of corner, with reference to Vol. and pg., dates, surveyor; exact description of monument replaced; if location computed, by taped or EDM traverse; landowner, remarks, etc.

*No RECORD OF CORNER
 SINCE ORIG. SURVEYS;
 SET THE CORNER MIDWAY
 BETWEEN SW CORNER & NW
 CORNER & ON LINE; USED
 GPS & EDM METHODS.*

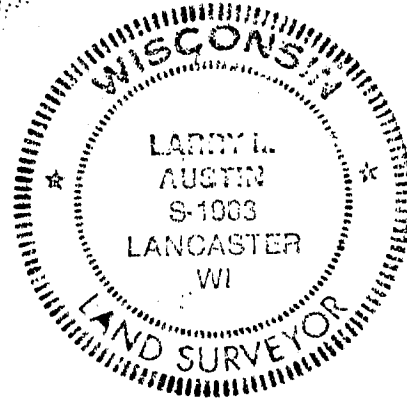


CERTIFIED CORRECT

Larry L. Austin
 Registered Land Surveyor

DATE: 9-20-94

TIE SKETCH

Show at least three (3) ties and monument

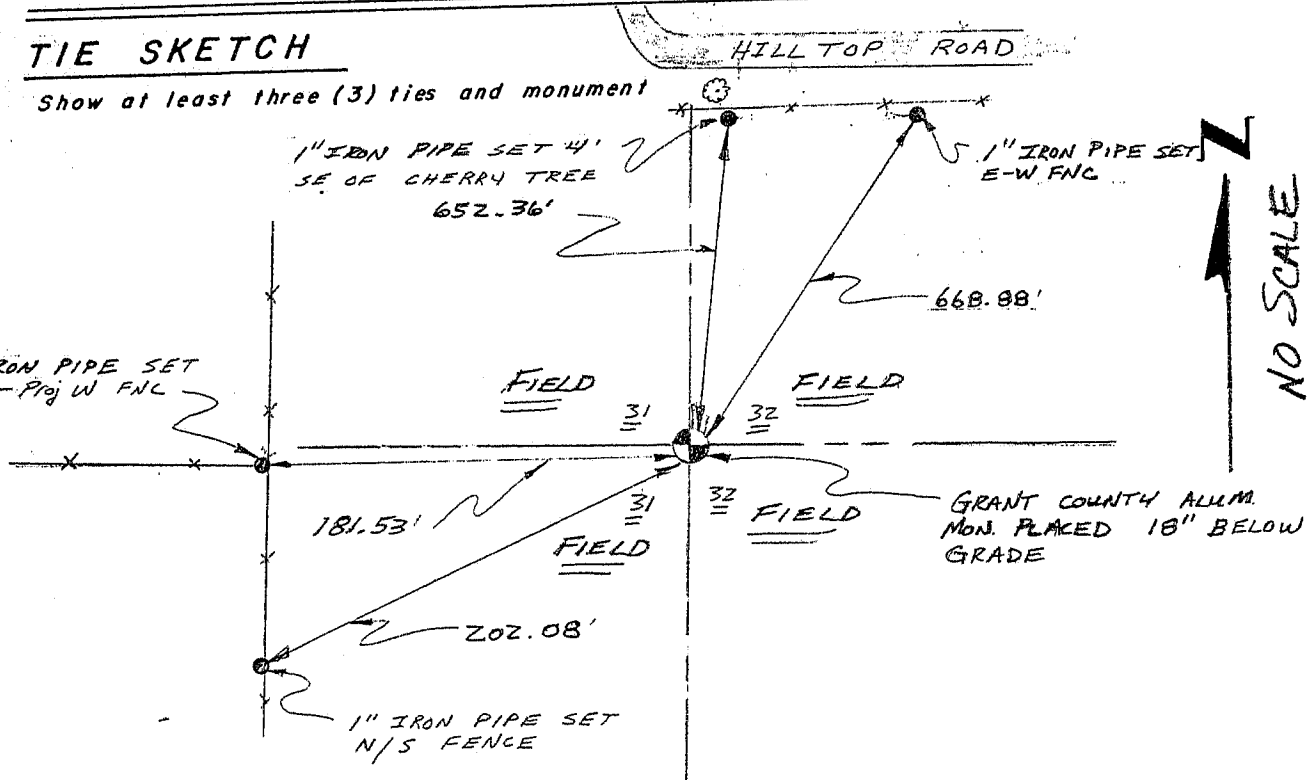

NO SCALE