


GRANT COUNTY

Survey Monument Record

TYPE OF MONUMENT 3/4" x 24" IRON BAR SET
 STATE PLANE COORDINATES: N _____
 E _____
 ELEVATION — M.S.L. DATUM: _____
 THETA ANGLE: _____
 FIELD BOOK: _____
 PAGE: _____

CORNER NO. 116
 SECTION 32
 TOWN 6N
 RANGE 3W
E 1/4 COR

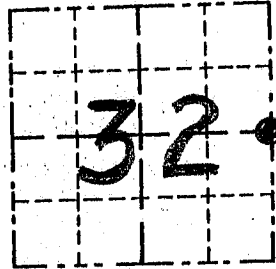

LOCATION
 (Indicated by "●")


BASIS FOR MONUMENT LOCATION

(Use reverse side if necessary)

Show info such as: History of corner, with reference to Vol. and pg., dates, surveyor; exact description of monument replaced; if location computed, by taped or EDM traverse; landowner, remarks, etc.

SEAL:

*No RECORD OF CORNER FOUND
 SINCE ORIG. SURVEYS.
 SET CORNER AT OCCUPIED LOCATION
 & VERIFIED ITS LOCATION BY
 EDM TRAVERSE OF THE AREA.*

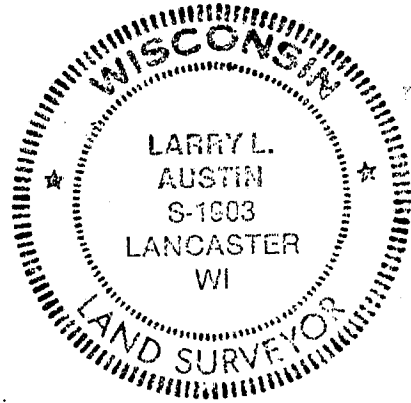

CERTIFIED CORRECT

Larry L. Austin
 Registered Land Surveyor

DATE: 10/7/94

TIE SKETCH

Show at least three (3) ties and monument

