


GRANT COUNTY

Survey Monument Record

TYPE OF MONUMENT COUNTY MONUMENT
 STATE PLANE COORDINATES: N _____
 E _____
 ELEVATION — M.S.L. DATUM: _____
 THETA ANGLE: _____
 FIELD BOOK: 95-06
 PAGE 13

CORNER NO. 23
 SECTION 12
 TOWN 6N
 RANGE 4W
NW COR

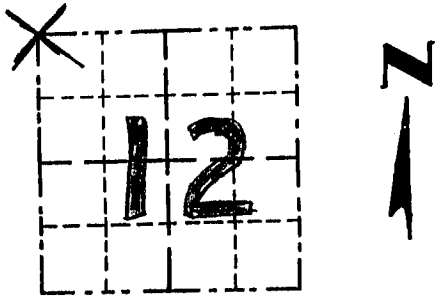

LOCATION
 (Indicated by "X")


BASIS FOR MONUMENT LOCATION

(Use reverse side if necessary)

Show info such as: History of corner, with reference to Vol. and pg., dates, surveyor; exact description of monument replaced; if location computed, by taped or EDM traverse; landowner, remarks, etc.

CORNER ORIGINALLY SET BY PARKE IN 1833; NO RECORD OF CORNER FOUND SINCE ORIGINAL SURVEYS; PROPORTIONED THE CORNER FOR N-S LOCATION TO SW CORNER OF SECTION 12 & W 1/4 CORNER OF SECTION 1; SET CORNER ON LINE BETWEEN W 1/4 CORNER SECTION 12 & W 1/4 CORNER SEC. 1. VERIFIED BY EDM TRAVERSE OF THE AREA.

SEAL:

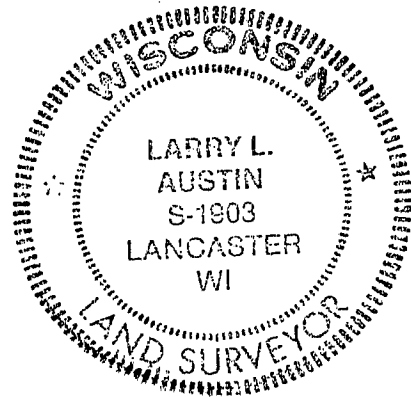

CERTIFIED CORRECT

Larry L. Austin
 Registered Land Surveyor
 DATE: 4/20/95

TIE SKETCH

Show at least three (3) ties and monument

