


Survey Monument Record

CORNER NO. 103
 SECTION 25
 TOWN 6N
 RANGE 4W

TYPE OF MONUMENT 3/4" rebar
 STATE PLANE COORDINATES: N _____
 E _____
 ELEVATION — M.S.L. DATUM: _____
 THETA ANGLE: _____
 FIELD BOOK: 94-5
 PAGE _____

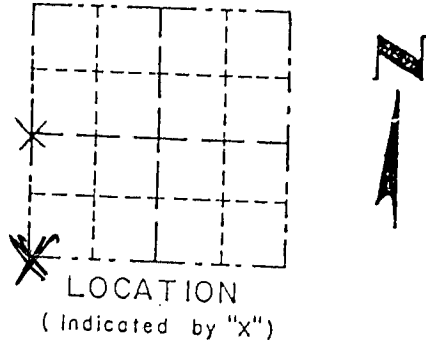

BASIS FOR MONUMENT LOCATION

(Use reverse side if necessary)
 Show info such as: History of corner, with reference to Vol. and pg., dates, surveyor; exact description of monument replaced; if location computed, by taped or EDM traverse; landowner, remarks, etc.

SEAL:

There are no recent survey records of this corner. The occupied location of a 3 way fence intersection was monumented after an E.D.M. traverse of the area.



CERTIFIED CORRECT
Laurence E. Schmit
 Registered Land Surveyor
 DATE: 7-11-94


TIE SKETCH

Show at least three (4) ties and monument

(A) B
 R.S. Nail 12' UP
 E. Side 6" Elm
 1/2" Iron Pipe

(C) D
 R.S. Nail 3' UP
 N. Side 6" Elm

(E) F
 R.S. Nail 13' up
 E. Side 5" Elm

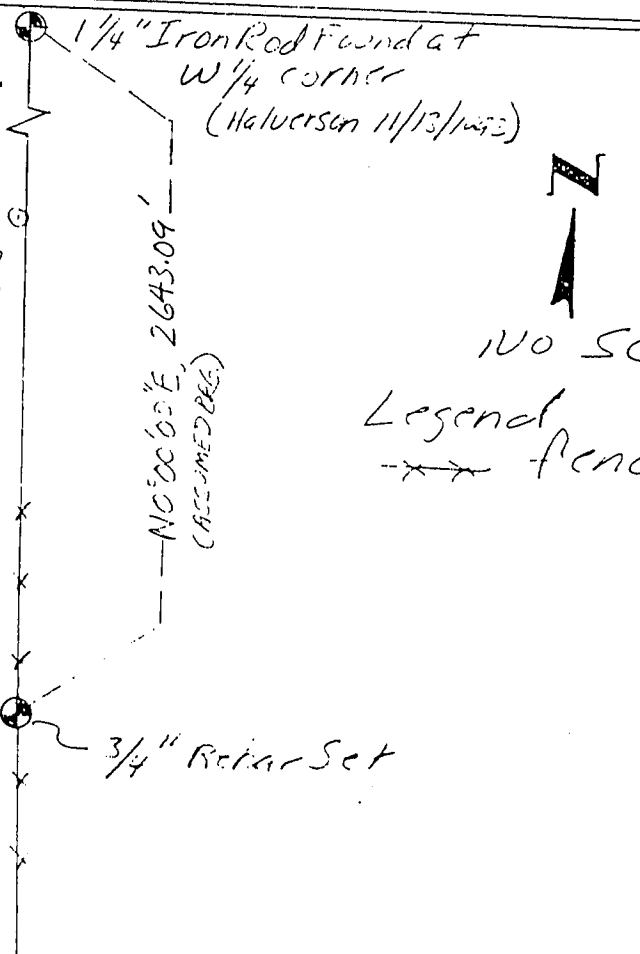

NO SCALE

Legend
 -X-X- fence

- Ties and Distance from corner
- 1 N 0°24'49"W, 80.73'
 - 2 N 31°05'35"W, 98.55'
 - 3 N 21°18'30"W, 38.81'
 - 4 N 27°22'34"W, 18.58'