

Survey Monument Record

CORNER NO. _____

SECTION 35

TOWN 6 NORTH

RANGE 4 WEST

TYPE OF MONUMENT 3/4" X 24" Iron Rod


STATE PLANE COORDINATES: N _____
E _____

ELEVATION — M.S.L. DATUM: _____

THETA ANGLE: _____

FIELD BOOK: _____

PAGE _____

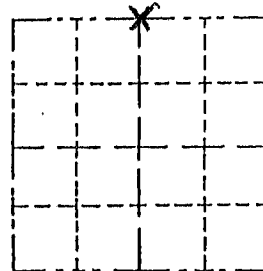

LOCATION
(Indicated by "X")


- FOUND PERPETUATED LOCATION
- OBLITERATED EVIDENCE LOCATION
- LOST CORNER (RESTORED BY PROPORTIONATE METHODS)

BASIS FOR MONUMENT LOCATION

(Use reverse side if necessary)

Show info such as: History of corner, with reference to Vol. and pg., dates, surveyor; exact description of monument replaced; if location computed, by taped or EDM traverse; landowner, remarks, etc.

I FOUND NO HISTORY OF THIS CORNER SINCE THE ORIGINAL GOVERNMENT SURVEY. I SET THIS CORNER ON THE EXTENTION OF A FENCE LINE ALONG THE NORTH LINE OF THE NE 1/4 AND THE SPLIT DISTANCE BETWEEN THE NE CORNER AND THE NW CORNER OF SECTION 35. AFTER AN E.D.M. TRAVERSE AND LOCATION SURVEY OF SECTIONS 35 & 26

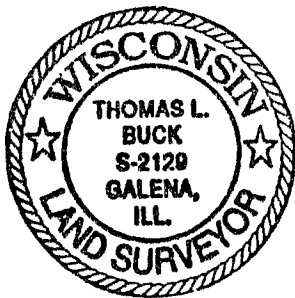


CERTIFIED CORRECT TO THE BEST OF MY KNOWLEDGE AND BELIEF

Thomas Buck
Registered Land Surveyor

DATE: 7/30/99

TIE SKETCH

Show at least three (3) ties and monument

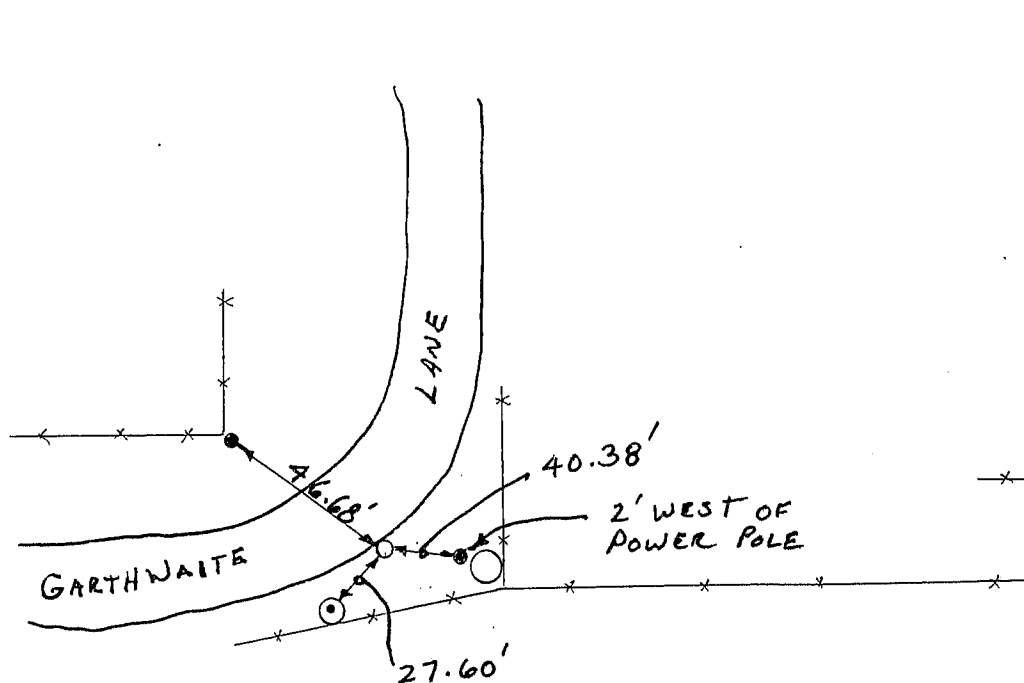

NO SCALE

- = 3/4" X 24" IRON ROD
- = 1/2" IRON ROD
- ⊙ = P.K. w/SHINER ON TOP BRACE POST
- *—*— = EXISTING FENCE