

U.S. PUBLIC LAND SURVEY MONUMENT RECORD - GRANT COUNTY, WI



Section 24, Town 6 North Range 5 West, Town of Patch Grove

CERTIFICATE:

I, Aaron J. Austin, Wisconsin Professional Land Surveyor, do hereby certify that the corner location on this record was determined by me and/or under my direct supervision and that this U.S. Public Land Survey Monument Record is correct and complete to the best of my knowledge and belief.

Dated this 11th day of March, 2016.


Aaron J. Austin, S-2922

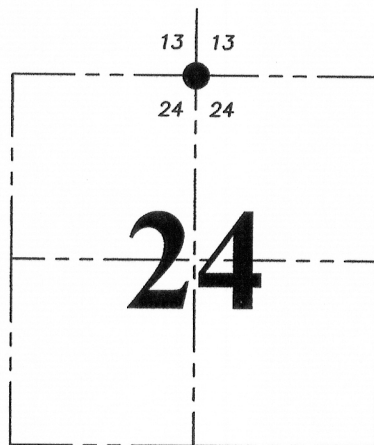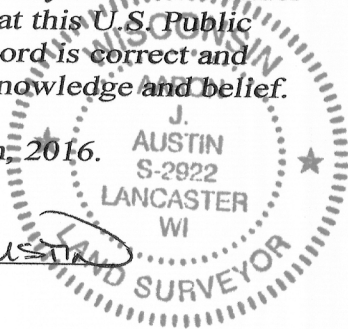

● = CORNER LOCATION

HISTORY OF CORNER ESTABLISHMENT:

1833-Harvey Parke set original corner.


2002-Larry Austin reset the corner and filed a U.S. Public Land Survey Monument Record.

DESCRIPTION OF CORNER EVIDENCE FOUND:

I found the 1" rebar with Grant County Aluminum Cap set by Larry Austin in place. I found 2 witness corners and set 2 new ones after I verified this location with E.D.M. and G.P.S. methods.

DESCRIPTION OF CORNER AND WITNESS MONUMENTS, references and accessories used to perpetuate the original or re-established location of this corner. Witnesses to corner location Shane Austin.

SKETCH:

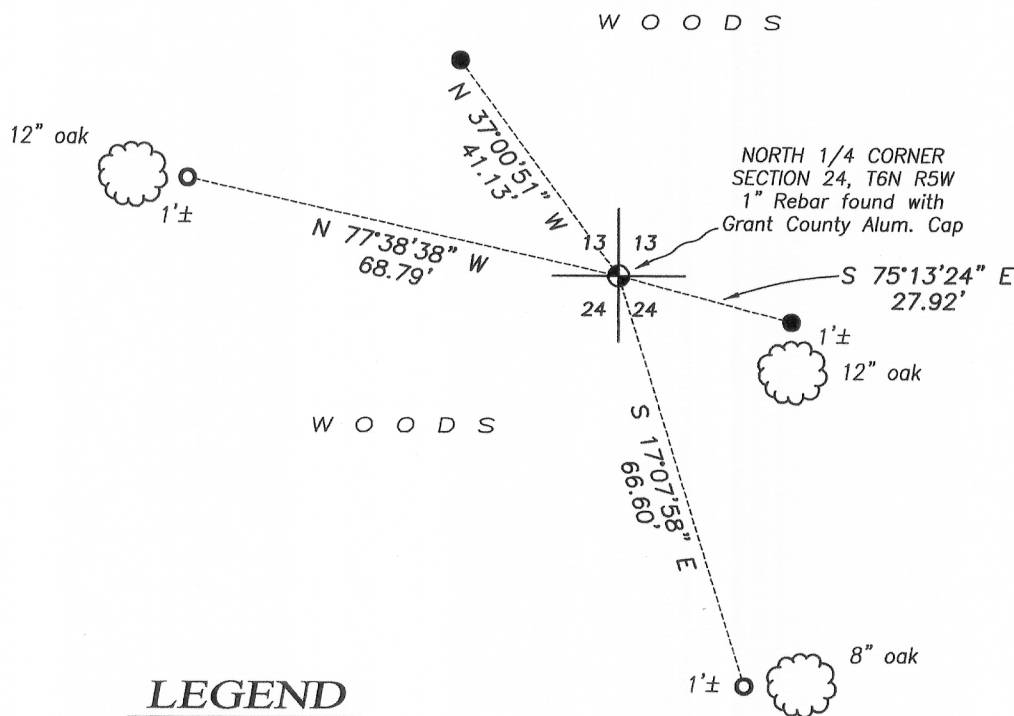

LEGEND

- Section Corner—as designated
- 1/2" x 12" Rebar set
- 1/2" rebar found

0 30 60
SCALE 1" = 30'



Austin
Engineering LLC
austinengineeringllc.com

4211 HWY 81 E, LANCASTER, WI 53813
PHONE: 608-723-6363 FAX: 608-723-6702

JOB NO: 16s006
H:\CRD\16s006
H:\TIE\T6NR5W\62(B)

FIELDBOOK: TDSR
DRAWN BY: AJ AUSTIN
CREW: SW AUSTIN


U.S. PUBLIC LAND SURVEY MONUMENT RECORD - GRANT COUNTY, WI
Section 13, Town 6 North Range 5 West, Town of Millville

CERTIFICATE

I, Larry L. Austin, do hereby certify that the corner location on this record was determined by me and/or under my direct supervision and that this U.S. public land survey monument record is correct and complete to the best of my knowledge and belief.

Dated this 15th day of July, 2002

Larry L. Austin
Larry L. Austin S-1903

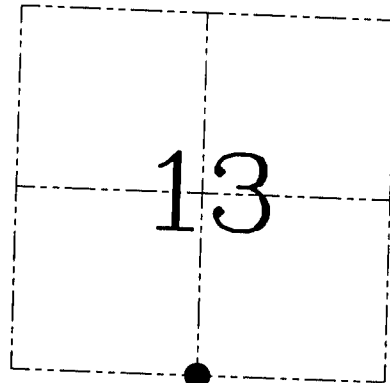

● = CORNER LOCATION

HISTORY OF CORNER ESTABLISHMENT


Corner was originally set in 1833 by Harvey Parke.
Hayden tied to the corner in 1858 while surveying in the Southwest 1/4 of Section 13.

DESCRIPTION OF CORNER EVIDENCE FOUND

The corner was set at a straight line proportion between the Southwest and Southeast corners of Section 13. Verified this location using EDM & GPS methods.

DESCRIPTION OF CORNER AND WITNESS MONUMENTS, references and accessories used to perpetuate the original or re-established location of this corner. Witnesses to the corner location Bobby Sedgwick & Shelby Blindert & Brad Digman

SKETCH:

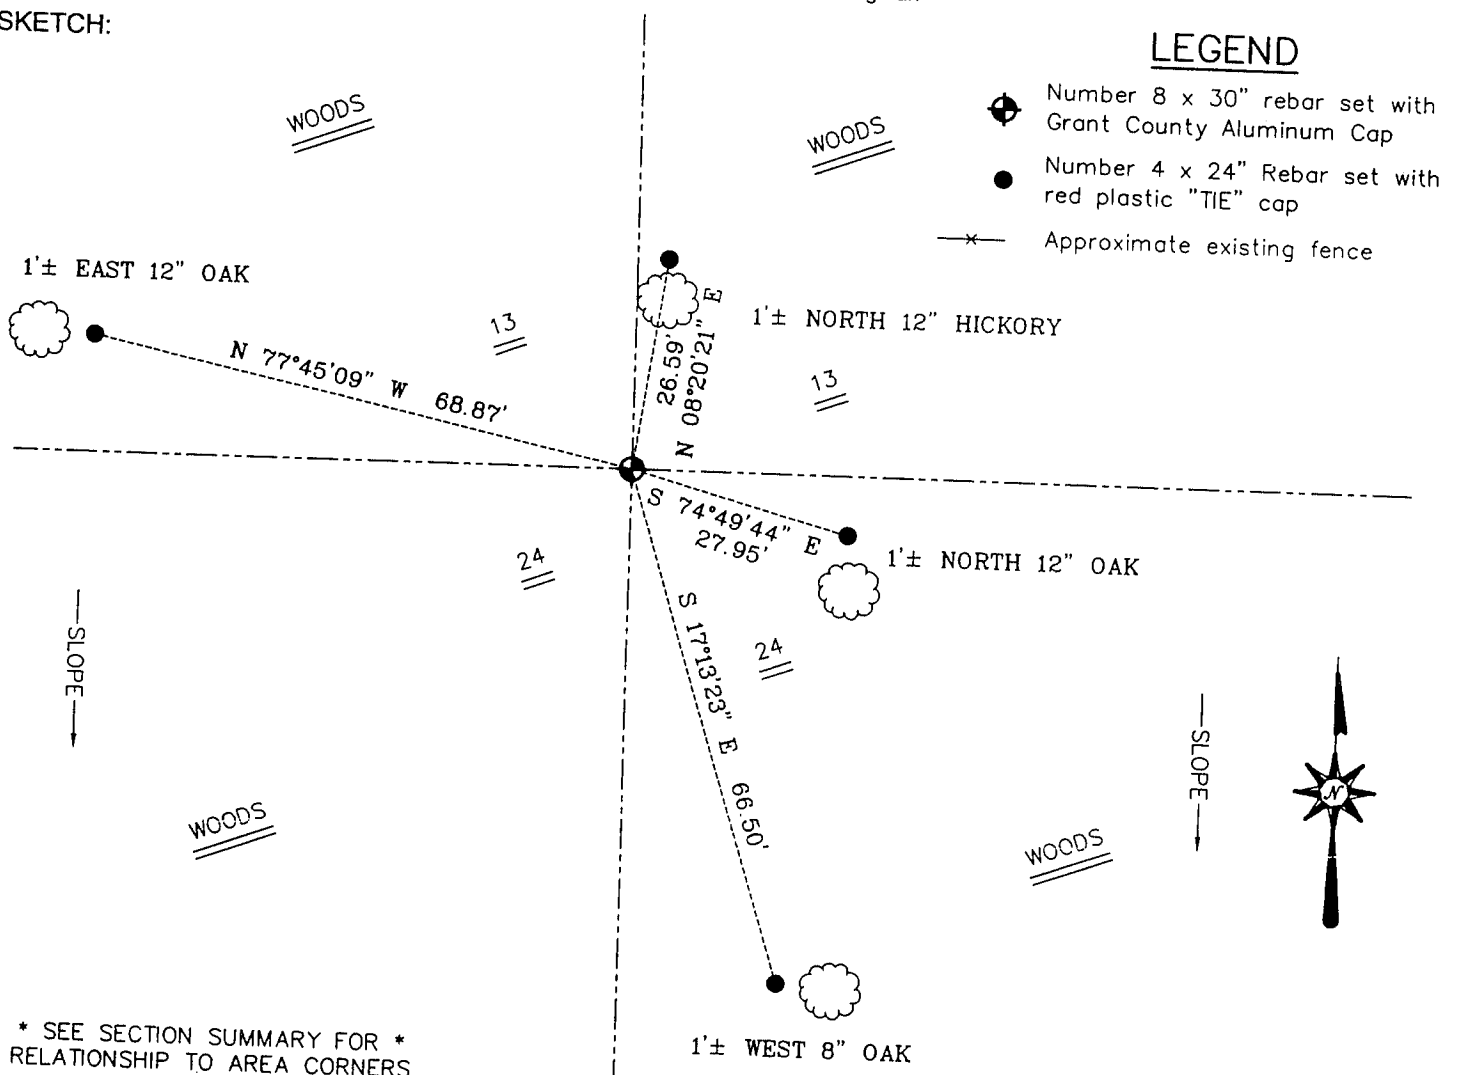

* SEE SECTION SUMMARY FOR *
RELATIONSHIP TO AREA CORNERS

AUSTIN ENGINEERING, LLC

4211 HWY 81 EAST, LANCASTER, WI 53813
PHONE 608-723-6363 FAX 608-723-6702

FIELDBOOK: SDR33, 2227

G: \T6NR5W\13

C: \SWA\TIE\T6NR5W\62

CREW: BS-SB-SA-BD

SKETCH NOT TO SCALE

DRAWN BY: SW AUSTIN

APPROVED: LL AUSTIN

CORNER NUMBER 62