

REC'D MAR 3 1997

71


# GRANT COUNTY U.S. PUBLIC LAND SURVEY MONUMENT RECORD

TYPE OF MONUMENT: 5/8" Diameter Iron Rod  
TIES ARE AS INDICATED ON SKETCH

WITNESSES TO CORNER LOCATION

Sean M. Walsh

Christopher G. Reedy

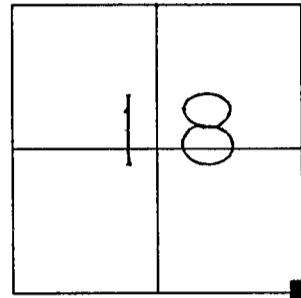

CORNER LOCATION

Southeast Corner  
Section 18  
Town 6 North, Range 5 West  
Millville Township

BASIS FOR MONUMENT LOCATION

In a 1984 survey of the North line of the Northeast One-Quarter of Section 19, T 6 N, R 5 W, Paul C. Brashaw re-established the Northeast Corner of Section 19 and monumented it with a "5/8" X 30" Rebar." A copy of this survey was found in Survey Record Book I, Page 187, Registry of Deeds, Grant County Courthouse.

The location of this monument fit well with my survey of the South One-Half of Section 18.

I have accepted and perpetuated this corner as shown hereon.

TIE SKETCH

■ - 5/8" Diameter Iron Rod at Corner

Tree ties are a 60d common pole spike set in a blaze at the base of the tree as indicated.

Tie distances were taped horizontally.

