

REC'D MAR 3 1997


# GRANT COUNTY U.S. PUBLIC LAND SURVEY MONUMENT RECORD

TYPE OF MONUMENT: 3/4" Iron Rod  
TIES ARE AS INDICATED ON SKETCH

WITNESSES TO CORNER LOCATION

Sean M. Walsh

Christopher G. Reedy

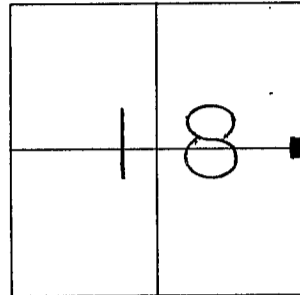

CORNER LOCATION  
East 1/4 Corner  
Section 18  
Town 6 North, Range 5 West  
Millville Township

BASIS FOR MONUMENT LOCATION

I located a 3/4" iron rod at this location of physical occupation and accepted it as the best available evidence.

I do hereby certify that this information is correct and true to the best of my knowledge and belief.

■ -- 3/4" Iron Rod at Corner

Tree ties are a 60d common pole spike set in a blaze at the base of the tree as indicated.

Tie distances were measured horizontally by taping.

TIE SKETCH

