

Survey Monument Record


TYPE OF MONUMENT 3/4" X 24" Iron Rod
 STATE PLANE COORDINATES: N _____
 E _____
 ELEVATION — M.S.L. DATUM: _____
 THETA ANGLE: _____
 FIELD BOOK: _____
 PAGE _____

CORNER NO. _____
 SECTION 27
 TOWN 6 NORTH
 RANGE 5 WEST

BASIS FOR MONUMENT LOCATION

(Use reverse side if necessary)


Show info such as: History of corner, with reference to Vol. and pg., dates, surveyor; exact description of monument replaced; if location computed, by taped or EDM traverse; landowner, remarks, etc.

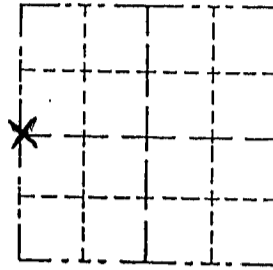

LOCATION
(Indicated by "X")

- FOUND PERPETUATED LOCATION
- OBLITERATED EVIDENCE LOCATION
- LOST CORNER (RESTORED BY PROPORTIONATE METHODS)

I SET THIS MONUMENT AT THE EXISTING FENCE INTERSECTION AFTER AN EDM TRAVERSE & LOCATION SURVEY OF THE ENTIRE SECTION.

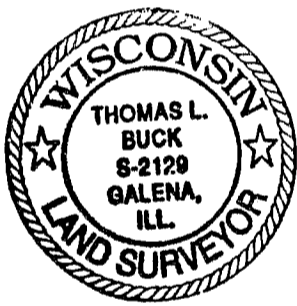


CERTIFIED CORRECT TO THE BEST OF MY KNOWLEDGE AND BELIEF

Thomas L. Buck
 Registered Land Surveyor

DATE: 5/6/99

TIE SKETCH

Show at least three (3) ties and monument

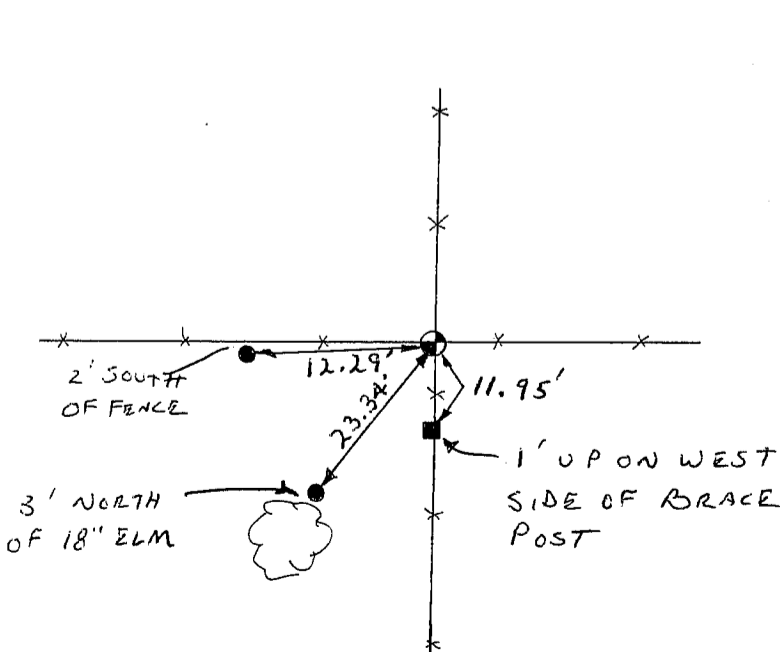

No Scale

- ⊙ = 3/4" X 24" Iron Rod
- = 1/2" Iron Rod
- = P.K. NAIL WITH SHINER
- x — x — x = EXISTING FENCE