

**U.S. PUBLIC LAND SURVEY MONUMENT RECORD**


(As Required By s. A-E 7.08, WI Adm. Code)

History of original corner establishment and subsequent restorations and description of any record, monument, occupational, testimonial or other evidence considered: *I found no survey records of this corner since the original government. Historical records indicate a change of ownership at this corner until about a century ago. I pre-computed an approximate location of this corner using occupied corners and information from surveys by Austin Mallett that bypassed the corner. I found a change in fences along with other obvious evidence of the corner such as rocks piled in the corner. The change in ancient fence types was within 2.5' of my computed location and I accepted and monumented it as shown.*


- Corner was: (Check All That Apply)
- Restored through acceptance of an obliterated evidence location
  - Restored through acceptance of a found perpetuated location
  - Considered a lost corner and reestablished through lost corner proportionate methods (include a plan view drawing showing distances and directions to other Public Land Survey Corners used for proportioning and determining the corner location)
  - Restored or reestablished in a location that differs from a previous restoration or reestablishment (include a plan view drawing and indicate what was set and/or found)

Describe the monument and accessories used to perpetuate the location of this corner. (Include a plan view drawing and indicate what was set and/or found)


Grant Co. Coords  
 (N) 617025.38  
 (E) 864916.14

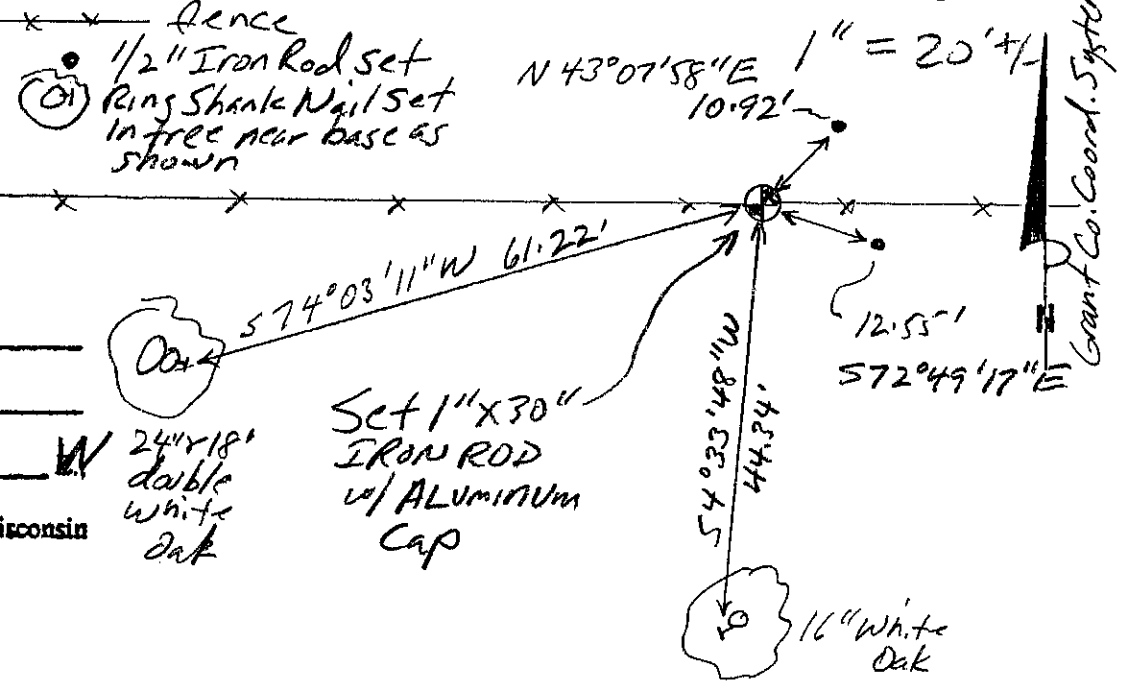

The N 1/4  
 corner of Section 7  
 T. 7 N., R. 1 W  
Grant County, Wisconsin  
 Job ID: 2003-38  
 Book # 6

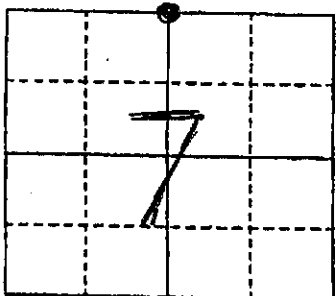

● = Location of Corner

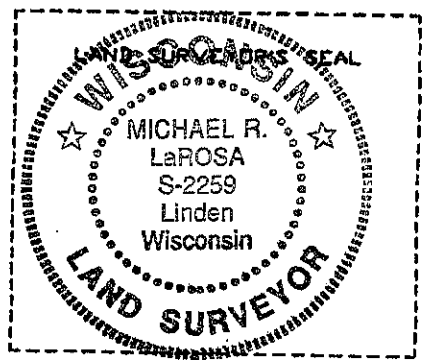

I, Michael R. LaRosa  
 Type or print name) certify that the corner location shown on this record was determined by me or under my direction and control and that this U.S. Public Land Survey Monument Record is correct and complete to the best of my knowledge and belief.

Michael R. LaRosa 8/21/2003  
 Signature Date

Index No. 32

OCT 16 2003