

U.S. PUBLIC LAND SURVEY MONUMENT RECORD

(As Required By s. A-E 7.08, WI Adm. Code)

History of original corner establishment and subsequent restorations and description of any record, monument, occupational, testimonial or other evidence considered: *I found no survey records of this corner. Ownership records indicate that this corner was occupied until the last generation or two. There is currently a corner post with a fence running southeast from an east-west fence. I found a 1 1/2" x 2" pipe buried horizontal south of this corner. The current land owner indicates that this post was replaced in the same location of the previous ancient corner. I found no other physical evidence in the area. Although this corner appears to be possibly too far east, it is proportionately balanced with the next several corners to the west and also fits the only remaining long standing internet subdivision ownership line (6 1/2 x 5 1/4) nearly perfectly, see section summary sheet. The corner was nearly perfectly on line between the NW & NE corners as well*

- Corner was: (Check All That Apply)
- Restored through acceptance of an obliterated evidence location
 - Restored through acceptance of a found perpetuated location
 - Considered a lost corner and reestablished through lost corner proportionate methods (include a plan view drawing showing distances and directions to other Public Land Survey Corners used for proportioning and determining the corner location)
 - Restored or reestablished in a location that differs from a previous restoration or reestablishment (include a plan view drawing and indicate what was set and /or found)



Describe the monument and accessories used to perpetuate the location of this corner. (Include a plan view drawing and indicate what was set and/or found)

Grant County Coordinates
 (N) 611,736.79
 (E) 870,324.06

Legend • 12" Landscape spike
 * * * fence
 1" = 10' +/-

Ties are all in one line

The N 1/4
 corner of Section 17
 T. 7 N., R. 1 W E.,
Grant County, Wisconsin
 Job ID: 2003-60
 Book # LL 77

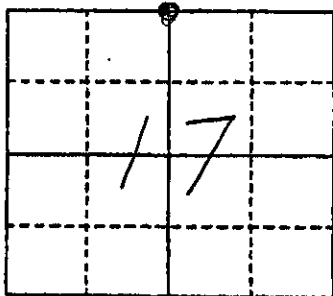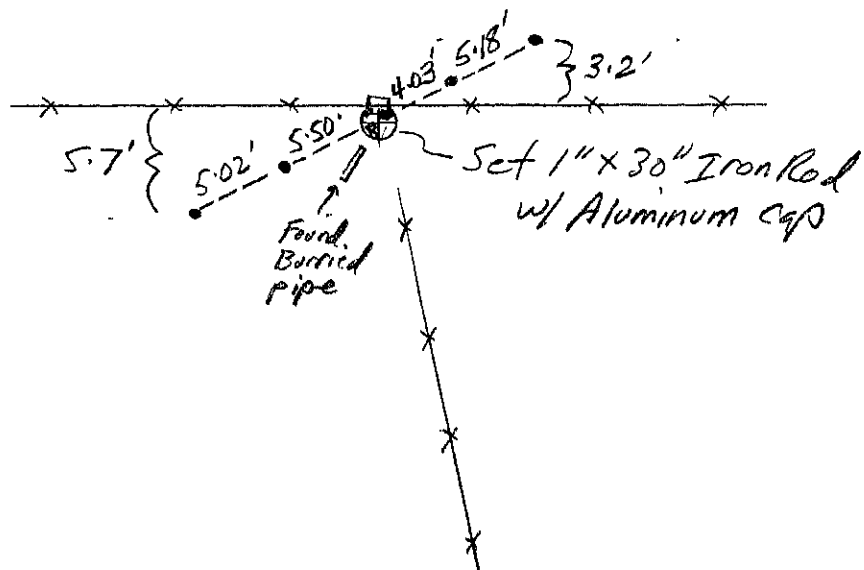

● = Location of Corner

Michael R. LaRosa

Type or print name certify that the corner location shown on this record was determined by me or under my direction and control and that this U.S. Public Land Survey Monument Record is correct and complete to the best of my knowledge and belief.

Michael R. LaRosa 4/13/2004

Signature

Date



Index No. 50