

Survey Monument Record

5 1/4


TYPE OF MONUMENT 1 1/4" Iron pipe
 STATE PLANE COORDINATES: N _____
 E _____
 ELEVATION — M.S.L. DATUM: _____
 THETA ANGLE: _____
 FIELD BOOK: 93-9
 PAGE _____

CORNER NO. _____
 SECTION 7
 TOWN 7N
 RANGE 2W

BASIS FOR MONUMENT LOCATION

(Use reverse side if necessary)

Show info such as: History of corner, with reference to Vol. and pg., dates, surveyor; exact description of monument replaced; if location computed, by taped or EDM traverse; landowner, remarks, etc.

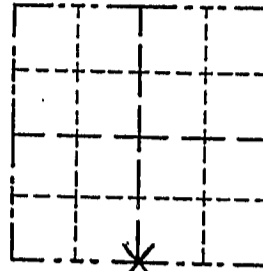

LOCATION
(Indicated by "X")


SEAL:

Ownership records back into the 1800's indicate that this corner has been maintained since this time. Testimonial evidence from area farmers (seniors) indicate this as well. Occupational evidence are fences N, S, E & W. The last survey record of this corner was a survey by Gould dated 4/22/1889. The corner was monumented after an EDM traverse of the area.

CERTIFIED CORRECT
Laurence E. Schmit

Registered Land Surveyor

DATE: 10/20/93

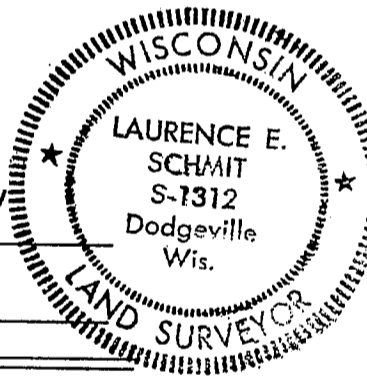

TIE SKETCH

Show at least three (4) ties and monument

