


E 1/4

# Survey Monument Record

TYPE OF MONUMENT 1" Iron Pipe  
 STATE PLANE COORDINATES: N \_\_\_\_\_  
 E \_\_\_\_\_  
 ELEVATION — M.S.L. DATUM: \_\_\_\_\_  
 THETA ANGLE: \_\_\_\_\_  
 FIELD BOOK: 93-9  
 PAGE \_\_\_\_\_

CORNER NO. \_\_\_\_\_  
 SECTION 7  
 TOWN 7 N  
 RANGE 2 W

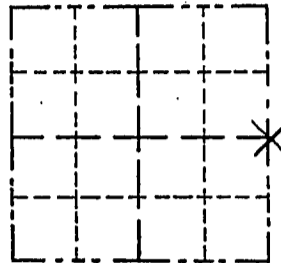

LOCATION  
(Indicated by "X")

## BASIS FOR MONUMENT LOCATION


(Use reverse side if necessary)

Show info such as: History of corner, with reference to Vol. and pg., dates, surveyor; exact description of monument replaced; if location computed, by taped or EDM traverse; landowner, remarks, etc.

SEAL:

The only survey record of this corner since the original government survey was a survey by Goold dated 4/22/1889. Ownership records back into the 1800's as well as testimonial evidence of area farmers (seniors) indicate that the corner location has been maintained since then. A 1" Iron Pipe was placed at the fence line intersection after an EDM traverse of the area.

CERTIFIED CORRECT  
*Laurence E. Schmit*  
 Registered Land Surveyor  
 DATE: 10/20/93

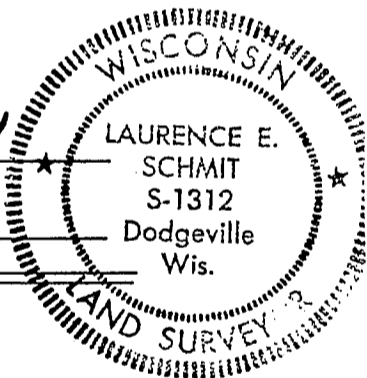

## TIE SKETCH

Show at least three (4) ties and monument

