

**U.S. PUBLIC LAND SURVEY MONUMENT RECORD**

(As Required By s. A-E 7.08, WI Adm. Code)

History of original corner establishment and subsequent restorations and description of any record, monument, occupational, testimonial or other evidence considered:


HISTORY IS THE ORIGINAL GOUT. FOUND A 1" IRON PIPE IN LINE WITH FENCE TO SOUTH  $\frac{1}{2}$  S'N OF SLEEPY HOLLOW ROAD. THE CORNER LOCATION FIT WITH FENCE EXTEND EAST OF CORNER, AND WAS ACCEPTED AFTER EDM & GPS TRAVERSE OF THE SECTION FOR PHYSICAL EVIDENCE. THE CORNER WAS LISTED BY CLARK IN A 1854 SURVEY

Corner was: (Check All That Apply)


- Restored through acceptance of an obliterated evidence location
- Restored through acceptance of a found perpetuated location
- Considered a lost corner and reestablished through lost corner proportionate methods (include a plan view drawing showing distances and directions to other Public Land Survey Corners used for proportioning and determining the corner location)
- Restored or reestablished in a location that differs from a previous restoration or reestablishment (include a plan view drawing and indicate what was set and /or found)

Describe the monument and accessories used to perpetuate the location of this corner. (Include a plan view drawing and indicate what was set and/or found)

11-59  $S0^{\circ}39'52''E$  42.25  
 11-119  $N63^{\circ}38'02''E$  29.60'  
 11-120  $N34^{\circ}11'49''E$  14.02'  
 11-121  $N62^{\circ}58'12''W$  22.05'

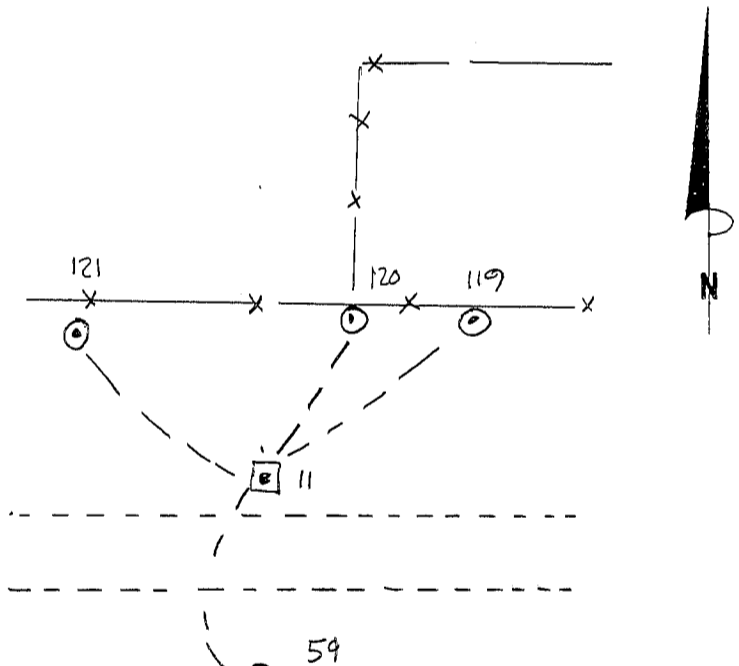


The W $\frac{1}{4}$   
 corner of Section 10  
 T. 7 N., R. 2W ~~E.~~,  
GRANT County, Wisconsin  
 Job ID: 2000S-77  
 Book # 2000-4 p.20

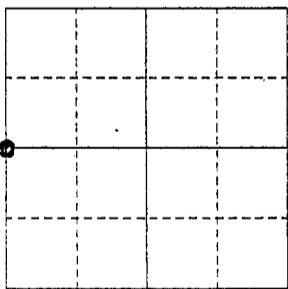

**LEGEND**

- REPLACED 1" PIPE WITH  $\frac{7}{8}$ "x24" REBAR WITH GRANT CO. ALUM CAP
- X FENCE
- SET  $\frac{1}{2}$ " IRON PIPE

● = Location of Corner

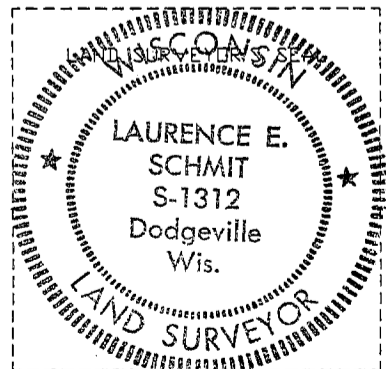

I, LAURENCE E. SCHMIT  
 (Type or print name) certify that the corner location shown on this record was determined by me or under my direction and control and that this U.S. Public Land Survey Monument Record is correct and complete to the best of my knowledge and belief.

*Laurence E. Schmit* 8-12-2000  
 Signature Date

Index No. 37