

RECEIVED

MAR 28 1995

ADD

GOVERNMENT CORNER RECORD

EAST 1/4 CORNER, SECTION 13, TOWNSHIP 7 NORTH, RANGE 2 EAST - WEST,

TOWN, CITY OR VILLAGE OF HICKORY GROVE

TYPE OF MONUMENT: 1 1/4" DIA. IRON ROD ELEVATION - M.S.L. DATUM _____


SECTION 13, T. 7 N, R. 2 EW
TOWN OF HICKORY GROVE

WITNESSES TO CORNER LOCATION

Sean M. Walsh

Christopher G. Reedy

Curtis J. Cummer

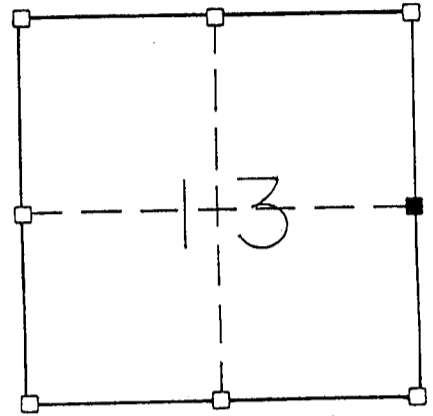

TIE SKETCH
(SHOW ALL HELPFUL FEATURES)

NORTH

FIELD

Drainage Ditch

FIELD

110.51'

WITEK ROAD

88.63'

82.53'

Field Road

FIELD

75.50'

Culverts

FIELD

COPY

SURVEYOR'S CERTIFICATE

SEAL S. 2016

I, Sean M. Walsh, DO HEREBY CERTIFY THAT I have re-established the above corner at the location of projected occupied lines along the East line of Section 13. This location fits well with the occupied centerline of Witek Road and offers the best available evidence. This information is correct and true to the best of my knowledge and belief.

DATED THIS 15 DAY OF MARCH, 1995

Sean M. Walsh
REGISTERED LAND SURVEYOR

