


REC'D MAY 27 1997

Survey Monument Record

TYPE OF MONUMENT 1/4" IRON PIPE SET
STATE PLANE COORDINATES: N _____
E _____
ELEVATION — M.S.L. DATUM: _____
THETA ANGLE: _____
FIELD BOOK: 97-3 ML BB
PAGE 43

CORNER NO. _____
SECTION 14
TOWN 7N
RANGE 2W

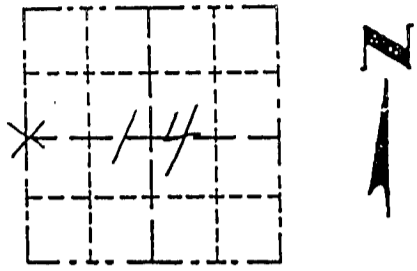

BASIS FOR MONUMENT LOCATION

(Use reverse side if necessary)

Show info such as: History of corner, with reference to Vol. and pg., dates, surveyor; exact description of monument replaced; if location computed, by taped or EDM traverse; landowner, remarks, etc.

LOCATION
(Indicated by "X")
 FOUND PERPETUATED LOCATION
 OBLITERATED EVIDENCE LOCATION
 LOST CORNER (RESTORED BY PROPORTIONATE METHODS)

There are no recent survey records of this corner. An existing 4 way intersection of (down) fence lines was accepted as the corner location after it fell reasonably close to the prorated location considering the terrain. Ownership records indicate that this corner has been occupied since the mid 1800's, no other physical evidence was found to contest this location.

CERTIFIED CORRECT TO THE BEST OF MY KNOWLEDGE AND BELIEF

Michael R. LaRosa
Registered Land Surveyor

DATE: 4/18/1997

TIE SKETCH

Show at least (4) ties and monument

