


Survey Monument Record

CORNER NO. _____ APR 24
 SECTION 22
 TOWN 7 N
 RANGE 2 W

TYPE OF MONUMENT 1" Iron Pipe Found
 STATE PLANE COORDINATES: N _____
 E _____
 ELEVATION — M.S.L. DATUM: _____
 THETA ANGLE: _____
 FIELD BOOK: 94-9
 PAGE _____

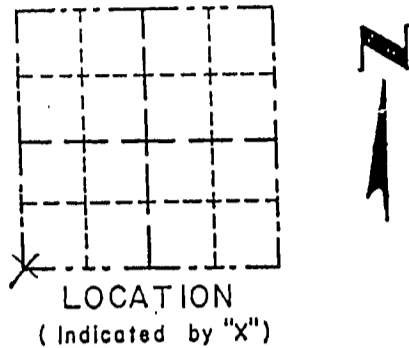


BASIS FOR MONUMENT LOCATION

(Use reverse side if necessary)

Show info such as: History of corner, with reference to Vol. and pg., dates, surveyor; exact description of monument replaced; if location computed, by taped or EDM traverse; landowner, remarks, etc.

SEAL:

An existing Iron pipe found 0.3' below grade and 2.5' west of a 24" oak on an East-west fence in line with fence remnants to south was accepted as the corner. This pipe was noted by Krohn in a survey dated 3/1977 and was purported to have been set by Sampson in a survey dated 12/1/1902. It fit existing physical evidence in section 22 well after an E.D.M. traverse.

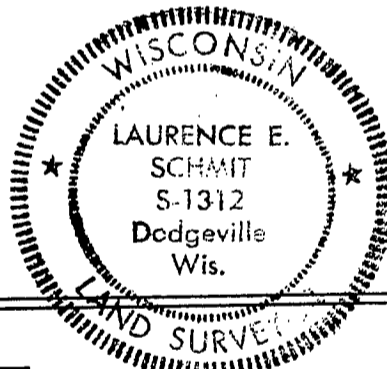

CERTIFIED CORRECT
Laurence E. Schmit
 Registered Land Surveyor
 DATE: 4-14-95

TIE SKETCH

Show at least three (4) ties and monument

Legend

- x — x — fence
- 3/8" Iron Rod Set

