


# Survey Monument Record

TYPE OF MONUMENT Grant Co. Driveable Aluminum  
 STATE PLANE COORDINATES: N \_\_\_\_\_  
 E \_\_\_\_\_  
 ELEVATION — M.S.L. DATUM: \_\_\_\_\_  
 THETA ANGLE: \_\_\_\_\_  
 FIELD BOOK: 95-5  
 PAGE \_\_\_\_\_

CORNER NO. \_\_\_\_\_  
 SECTION 23  
 TOWN 7N  
 RANGE 2W

## BASIS FOR MONUMENT LOCATION

(Use reverse side if necessary)  
 Show info such as: History of corner, with reference to Vol. and pg., dates, surveyor; exact description of monument replaced; location computed, by taped or EDM traverse; landowner, remarks, etc.

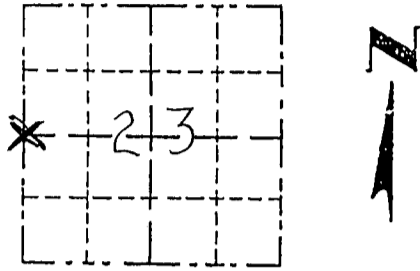

LOCATION  
 (Indicated by "X")

- FOUND PERPETUATED LOCATION
- OBLITERATED EVIDENCE LOCATION
- LOST CORNER (RESTORED BY PROPORTIONATE METHODS)

There are no recent survey records of this corner. The restored corner was placed at 1/2 the distance between the NW and SW corners on an existing long standing fence line (north-south). It fell 3.5' east of a straight line between these corners.

N 0-14-43 E  
 2627.87' ~ NW COR  
 W 1/4 COR 23-7-2W  
 N 0-23-52 E  
 2627.92' ~ SW COR



CERTIFIED CORRECT TO THE BEST OF MY KNOWLEDGE AND BELIEF

Michael R. LaRosa  
 Registered Land Surveyor  
 DATE: 6/19/1995

## TIE SKETCH

Show at least three (4) ties and monument

