


Survey Monument Record

CORNER NO. 97
 SECTION 28
 TOWN 7N
 RANGE 2W

TYPE OF MONUMENT 3/4" X 24" IRON
BAR SET AT CORNER

FIELD BOOK: 97-34
 PAGE _____

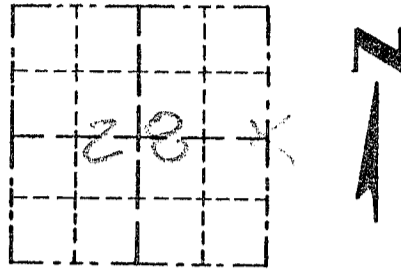

LOCATION
 (Indicated by "X")


BASIS FOR MONUMENT LOCATION

(Use reverse side if necessary)

Show info such as: History of corner, with reference to Vol. and pg., dates, surveyor; exact description of monument replaced; if location computed, by taped or EDM traverse; landowner, remarks, etc.

CORNER SET IN 1832 BY HARVEY PARKE, NO RECORD OF CORNER FOUND SINCE ORIGINAL SURVEYS; CORNER WAS SET ONLINE WITH EXISTING EAST/WEST FENCE FOR NORTHING, EASTING WAS SET BY DOUBLING THE DISTANCE FROM THE CENTER TO THE OCCUPIED 40 CORNER. VERIFIED ITS LOCATION USING EDM METHODS.

SEAL:

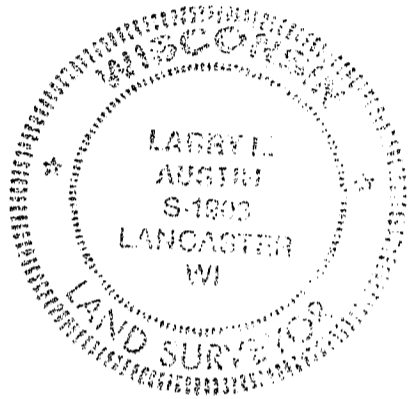

CERTIFIED CORRECT

Larry L. Austin
 Registered Land Surveyor

DATE: 12-31-97

TIE SKETCH

Show at least three (3) ties and monument

