

# GRANT COUNTY CERTIFIED LAND CORNER


CORNER NUMBER 128

**CERTIFICATE:**

I, Larry L. Austin, do hereby certify that on the 14th day of January, 2000, I found no evidence of the South 1/4 corner of Section 33, Town 7 North, Range 2 West, of the 4th Principal Meridian, and I re-established said corner according to the Wisconsin statutes as shown and described hereon.

Dated this 3rd day of February, 2000

*Larry L. Austin*  
Larry L. Austin S-1903

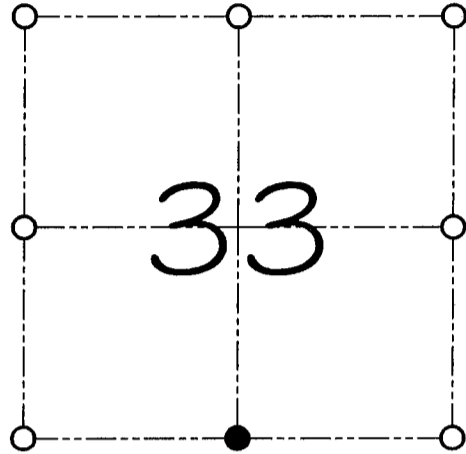

● = CORNER LOCATION

**SOUTH 1/4 CORNER OF  
SECTION 33, T 7 N R 2 W  
TOWN OF HICKORY GROVE**

**HISTORY OF ORIGINAL CORNER ESTABLISHMENT:**

Corner was originally set in 1832 by Sibley.  
No other record of the corner was found.

**DESCRIPTION OF CORNER EVIDENCE FOUND:**

I found no evidence of the location of the corner. I reset the corner online with fence North for Easting. Northing was based on evidence of the German cemetery. Verified this location using E.D.M. and G.P.S. methods.

**DESCRIPTION OF CORNER AND WITNESS MONUMENTS, references and accessories used to perpetuate the original or re-established location of this corner**

WITNESS TO THE CORNER LOCATION: SHELBY BLINDERT & BRIAN WINKERS

**SKETCH:**

• SEE SECTION SUMMARY FOR •  
RELATIONSHIP TO AREA CORNERS

LEGEND

- ⊕ Number 8 by 30" rebar set with Grant County aluminum cap
- Number 4 by 24" rebar set with red plastic cap
- ×× Existing fence location

