

GRANT COUNTY

Survey Monument Record

TYPE OF MONUMENT 3/4" x 24" IRON BAR SET

STATE PLANE COORDINATES: N _____
E _____

ELEVATION — M.S.L. DATUM: _____

THETA ANGLE: _____

FIELD BOOK: 96-14


PAGE (6)

CORNER NO. 2

SECTION 1

TOWN 6N

RANGE 2W

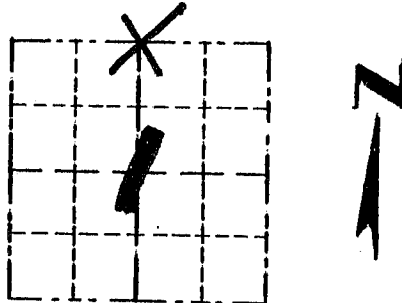

LOCATION
(Indicated by "X")

BASIS FOR MONUMENT LOCATION

(Use reverse side if necessary)

NO RECORD OF CORNER SEAL:
FOUND SINCE ORIGINAL SURVEYS.
I SET THE CORNER AT A
SINGLE PROPORTIONATE MEASUREMENT
BETWEEN THE NORTHWEST AND
THE NORTHEAST CORNERS OF
SECTION 1 T6N R2W. VERIFIED
THIS LOCATION USING EDM
METHODS.



CERTIFIED CORRECT

Larry L. Austin
Registered Land Surveyor

DATE: 9-10-96

TIE SKETCH

Show at least three (3) ties and monument

