

JAN 19 1996


GRANT COUNTY

SURVEY MONUMENT RECORD

NORTHWEST CORNER SECTION 7, T7N, R2W

TYPE OF MONUMENT: 3/4" X 24" IRON ROD PLACED
TIES ARE AS INDICATED ON SKETCH


SECTION 7, T7N, R2W

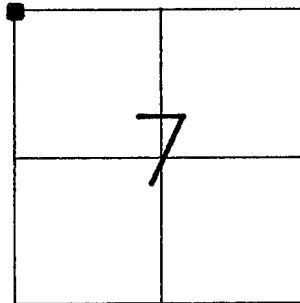

CORNER LOCATION

BASIS FOR MONUMENT LOCATION

I, SEAN M. WALSH, REGISTERED LAND SURVEYOR, DO HEREBY CERTIFY THAT I HAVE RE-ESTABLISHED THIS CORNER IN ACCORDANCE WITH THE INFORMATION CONTAINED HEREON AND THAT THIS INFORMATION IS CORRECT AND TRUE TO THE BEST OF MY INFORMATION, KNOWLEDGE AND BELIEF.

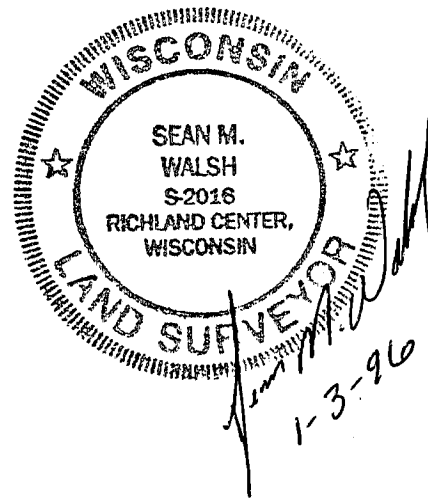

I HAVE RE-ESTABLISHED THIS CORNER AT THE LOCATION OF PHYSICAL OCCUPATION AS THE ONLY ACCEPTABLE EVIDENCE.

IN 1889 HERBERT J. GOULD LOCATED THIS CORNER AND DOCUMENTED THE FACT THAT ONE TREE REMAINED IN GOOD CONDITION, NO OTHER WITNESS TREES WERE MENTIONED. NO EVIDENCE OF ANY PREVIOUS SURVEY REMAINS, THUS I MONUMENTED THE LOCATION WHICH BEST FITS THE PROJECTION OF OLD PHYSICAL OCCUPATION.

