


GRANT COUNTY

Survey Monument Record

CORNER NO. 18
 SECTION 2
 TOWN 7N
 RANGE 3W

TYPE OF MONUMENT GRANT COUNTY MONUMENT SET
 STATE PLANE COORDINATES: N _____
 E _____
 ELEVATION — M.S.L. DATUM: _____
 THETA ANGLE: _____
 FIELD BOOK: 95-15
 PAGE _____

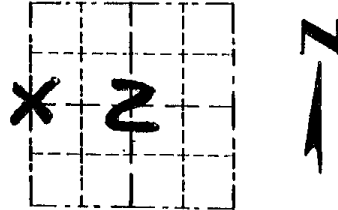

LOCATION
(Indicated by "X")

BASIS FOR MONUMENT LOCATION

(Use reverse side if necessary)

- ORIGINAL CORNER SET BY
 PARKE IN 1833
 - CORNER WAS SET ON
 LINE BETWEEN NW CORNER
 & SW CORNER OF THE
 SECTION & THE PROTECTION OF
 FENCE FROM THE EAST. THIS
 LOCATION FITS A DISTANCE TO
 THE CORNER SHOWN ON 1932
 D.O.T. PLAN NO. 376 "B" WITHIN
 3'; VERIFIED BY EDM TRAVERSE

SEAL:



CERTIFIED CORRECT

Larry L. Austin
 Registered Land Surveyor

DATE: 2/17/96

TIE SKETCH

Show at least three (3) ties and monument

