


REC'D FEB 13 1997

GRANT COUNTY U.S. PUBLIC LAND SURVEY MONUMENT RECORD

TYPE OF MONUMENT: 5/8" Capped Iron Rod
TIES ARE AS INDICATED ON SKETCH

WITNESSES TO CORNER LOCATION

Sean M. Walsh
Christopher G. Reedy

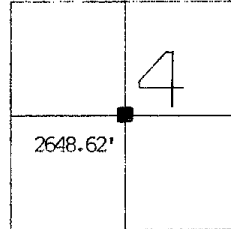


CORNER LOCATION
Section 4
Town 7 North, Range 3 West

BASIS FOR MONUMENT LOCATION

This corner was established by Paul C. Brashaw in 1984.
I have accepted and perpetuated this corner as shown hereon.

This information is correct and true to the best of my knowledge
and belief.

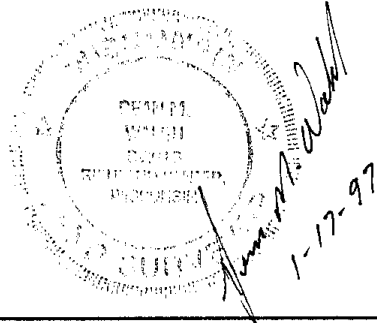

- - 5/8" Capped Iron Rod found at Corner
 - - 3/4" X 24" Iron Rod Set as Tie
- Tree ties are a 60d common pole spike set in a blaze at the base of the tree as indicated.
- Tie distances were taped horizontally.

TIE SKETCH

